


T. 38 S., R. 5 W., W.M.

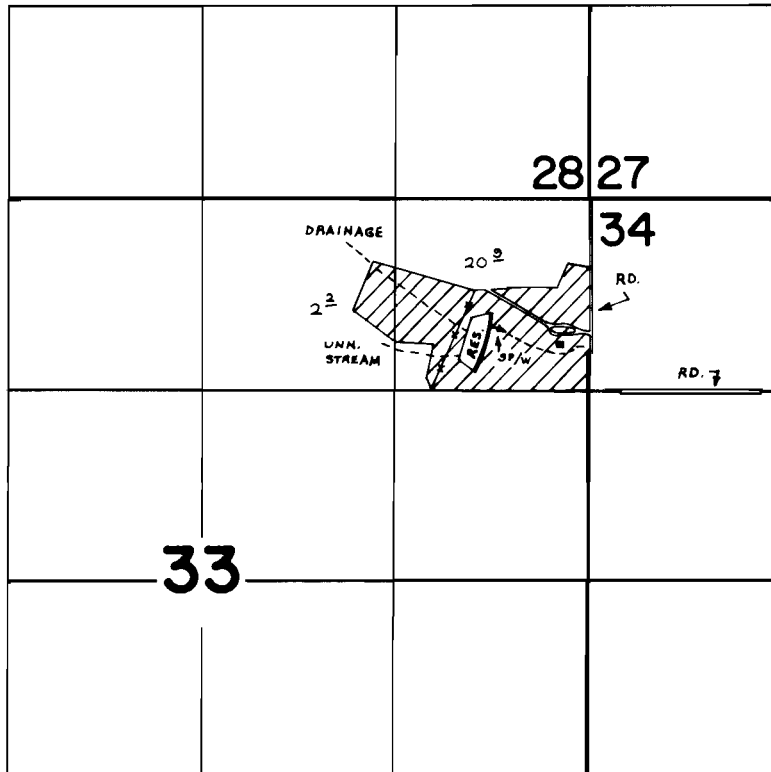

DAM LOC: 880' S. & 680' W. FROM N.E. COR. SEC. 33

FINAL PROOF SURVEY UNDER

R-52050 R-6283
 Application No. 52051 Permit No. 39227
 IN NAME OF

Bob Plev

Surveyed OCT. 21 1977, by B. SUND