


T.18S.,R.2W.,W.M.

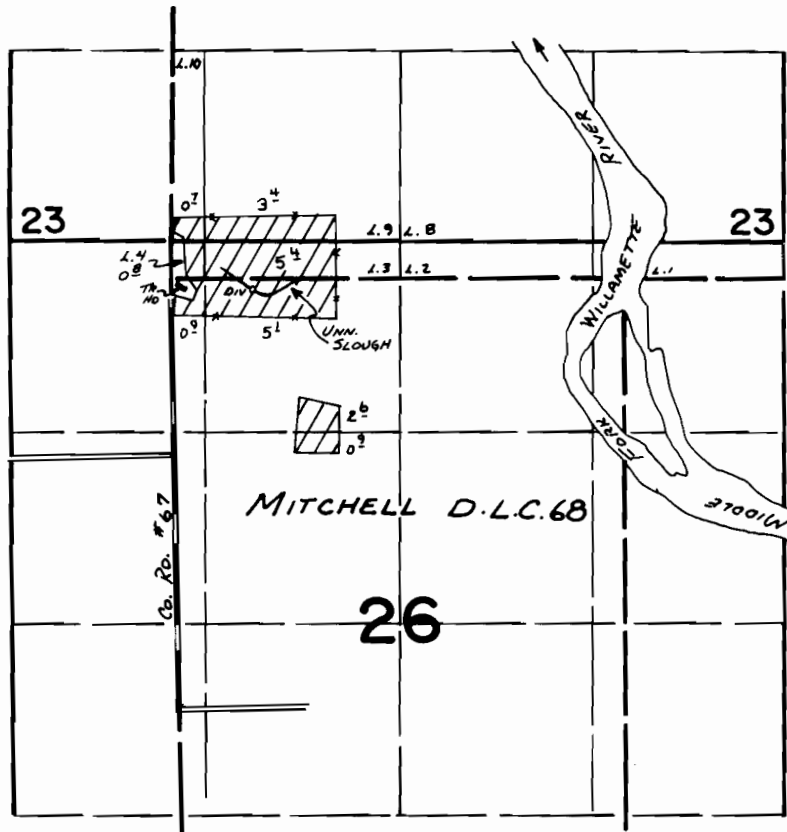

FINAL PROOF SURVEY
UNDER

Application No. 51154 Permit No. 38663
IN NAME OF

EDWARD H. CRAYTOR AND RICHARD & CHRISTINE DICKSON

Surveyed JUNE 18 1976, by L. TOLL