


T.17S. R.6W. W.M.

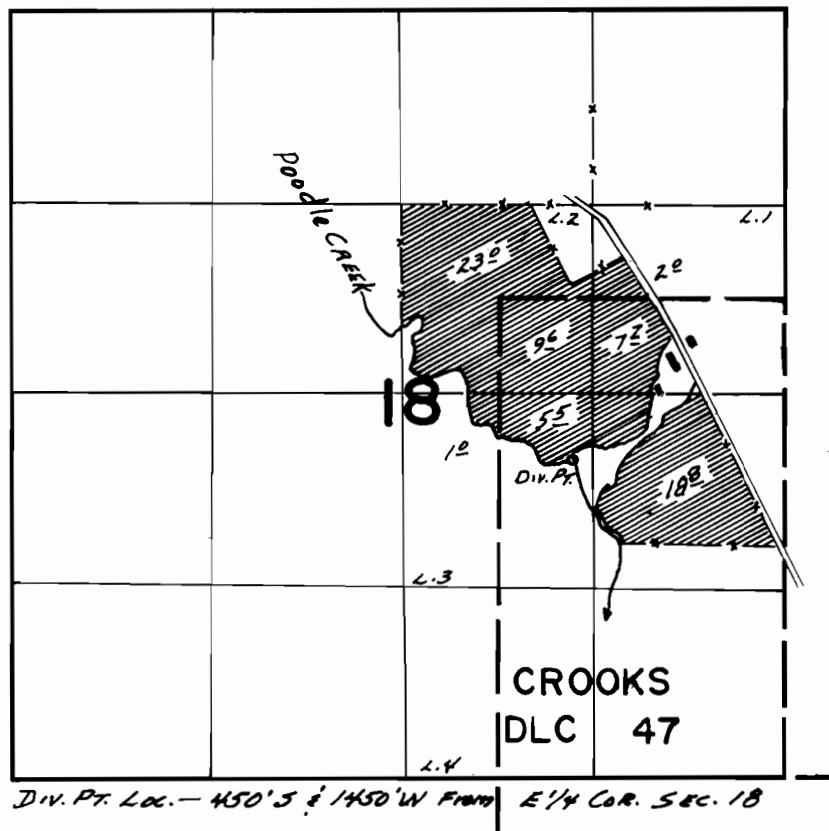

FINAL PROOF SURVEY
UNDER

Application No. 52259... Permit No. 39328...
IN NAME OF

WILLIAM F. RANEY

Surveyed MAY 7 1976, by L.H. NUNN