


T.9S., R.10W., W.M.

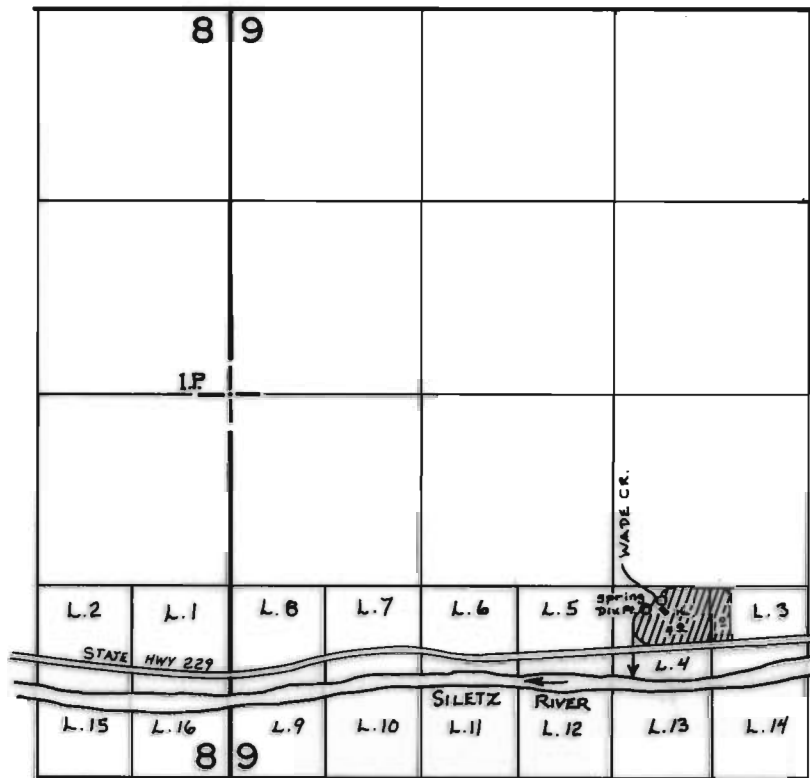

Spring Located 100' S & 325' E of Div. Pt. Located 175' S & 225' E both from NW cor. of Lot 4 (SW 1/4 SE 1/4)

FINAL PROOF SURVEY UNDER

Application No. 49528 Permit No. 37124
IN NAME OF

MERLE F. and/or TRICIA G. BAKER

Surveyed OCT. 26 1977, by J.S.DONALDSON