


# T. 10S. R. 10W. W.M.

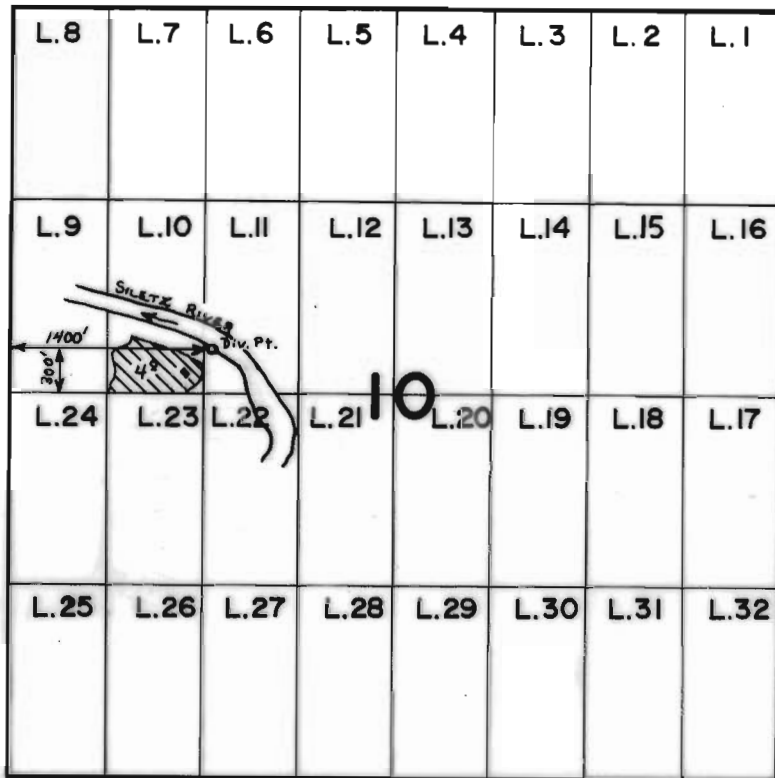

## FINAL PROOF SURVEY UNDER

Application No. 51686... Permit No. 38970.  
IN NAME OF

HAROLD L. ROSS

Surveyed OCT. 25, 1977., by J.S.DONALDSON