


T. 13 S., 10 W., W.M.

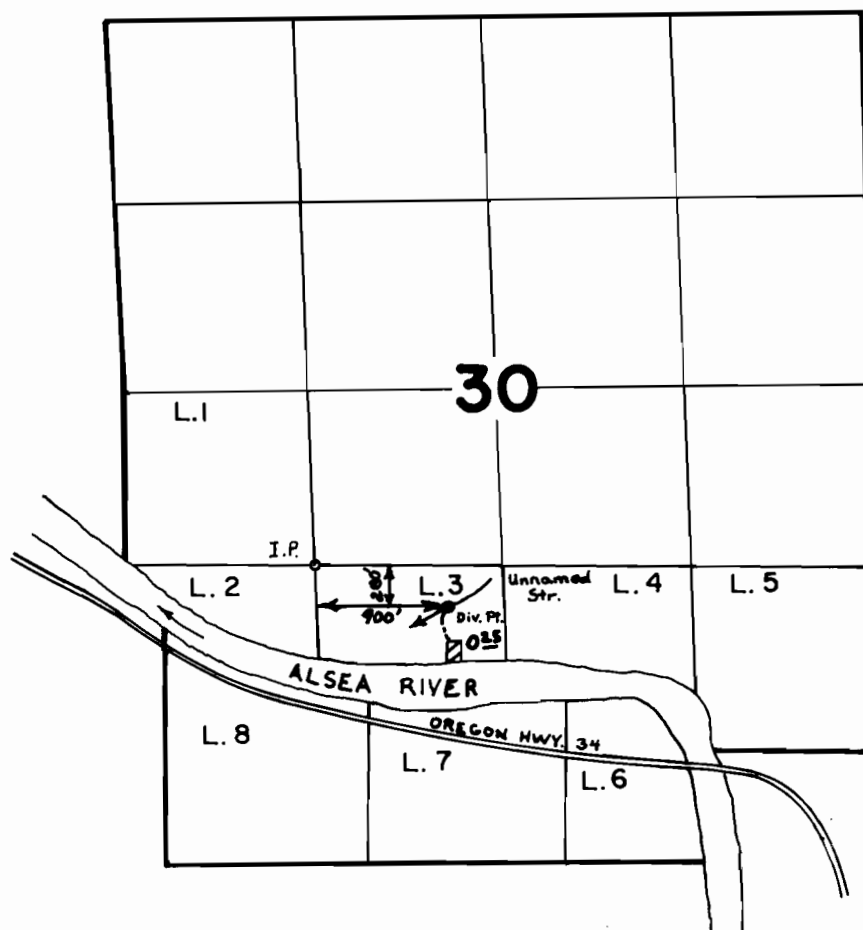

FINAL PROOF SURVEY
UNDER

Application No. 52337 Permit No. 39361
IN NAME OF

CHARLES KING

Surveyed AUG. 9 1976, by D. NORBY