


T.6S.,R2W.,W.M.

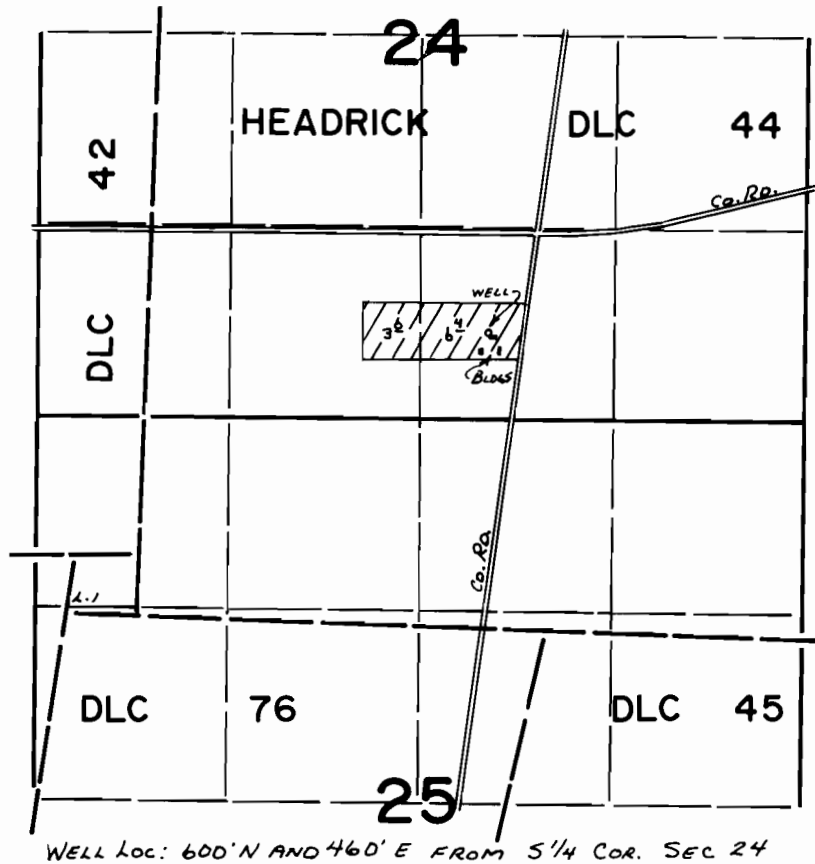

FINAL PROOF SURVEY
UNDER

Application No. G-6445 Permit No. G-5246
IN NAME OF

MIKE B. PORTER

Surveyed MAY 17 1976, by L. TOLL