


T.7S.,R.2W.,W.M.

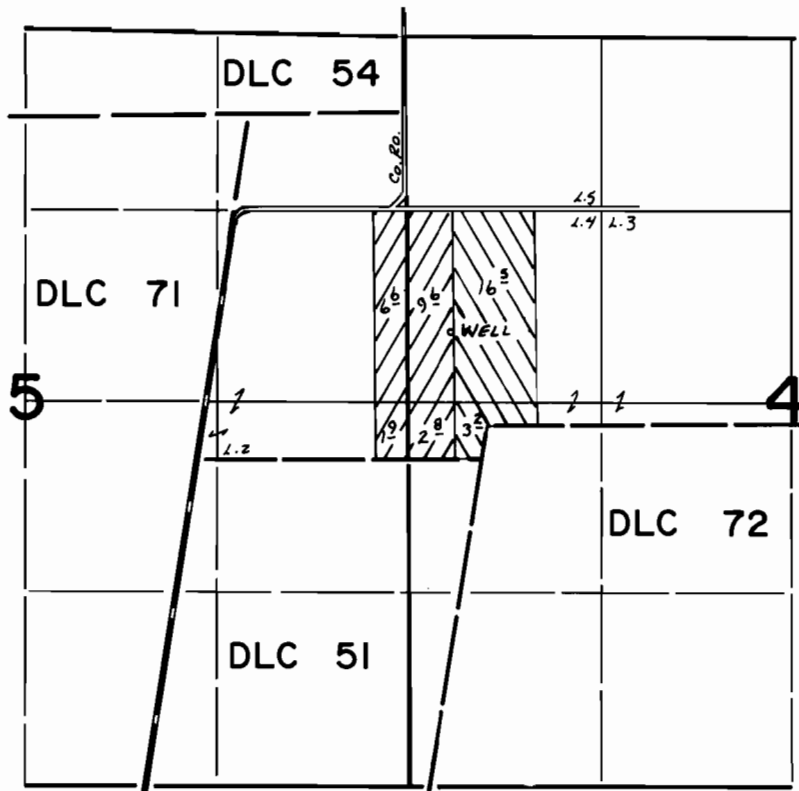

WELL LOC: 480' N AND 300' E FROM W 1/4 COR SEC 4

FINAL PROOF SURVEY UNDER

Application No. G-6788 Permit No. G-6299
G-7404 G-6908
 IN NAME OF



MARLAN C. JOHNSON

Surveyed JUNE 3 1976, by L. TOLL