T.7S.,R.2W.,W.M.

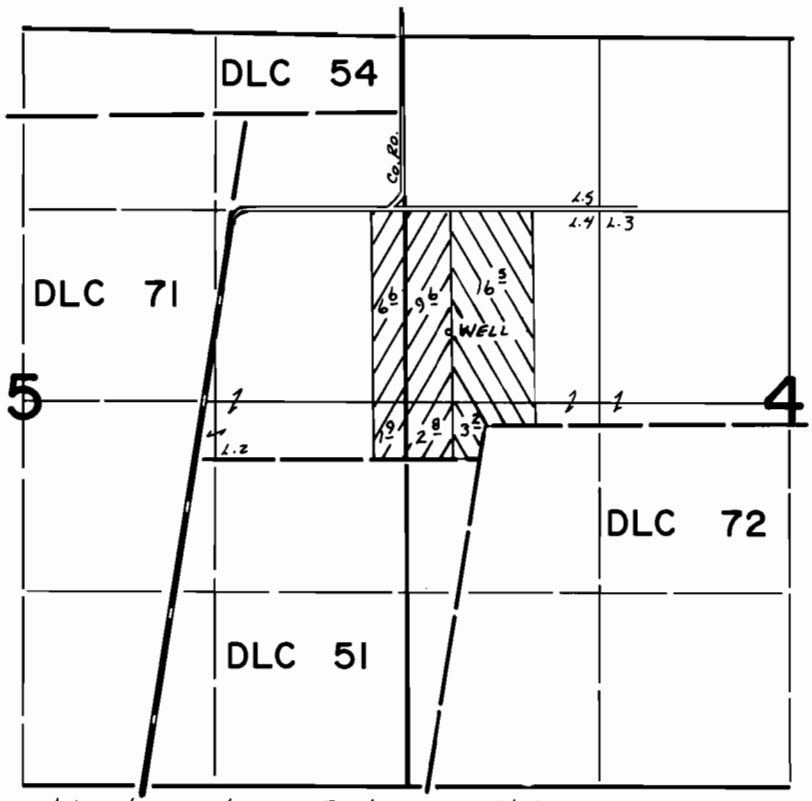

WELL LOC: 480'N AND 300'E FROM W 1/4 COR SEC 4

FINAL PROOF SURVEY
UNDER

Application No. G-7404 (G-6788) Permit No. G-6908 (G-6299)

IN NAME OF

MARLAN C. JOHNSON

Surveyed June 3 19 76, by L. Toll

DFN-bLL-145