


T. 7 S., R. 1 W., W.M.

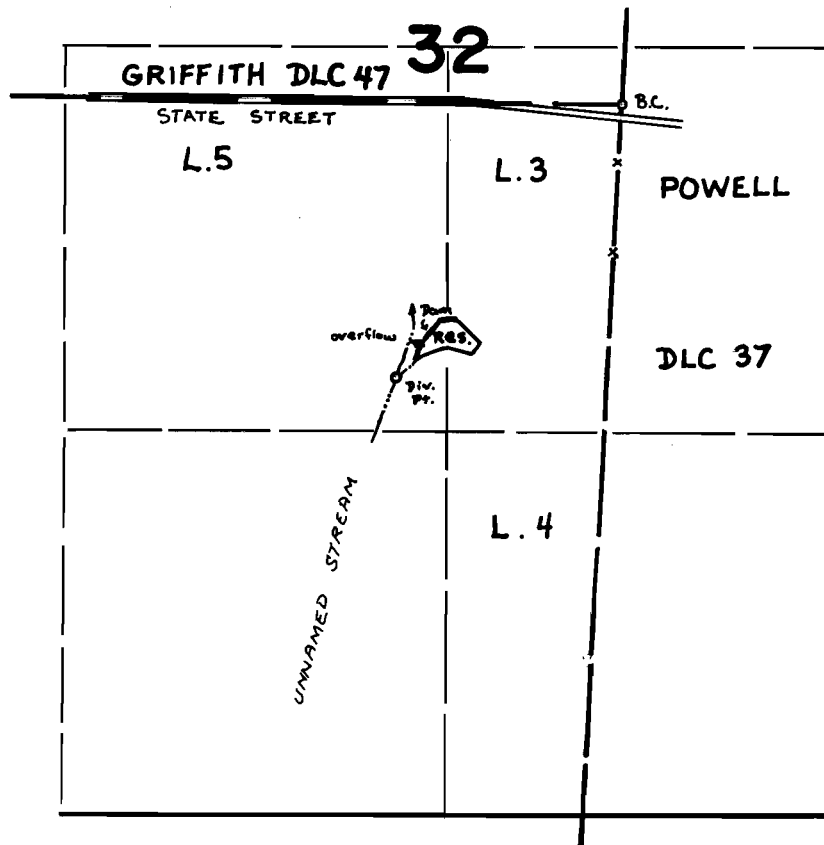

Div. Pt. Located: 950' S & 775' W
Dam Located: 825' S & 675' W
both from S.E. cor Griffith DLC 47

SCALE: 1" = 660'

FINAL PROOF SURVEY UNDER

R-53415 R-6155
Application No. 53416 Permit No. 38072
IN NAME OF

HERBERT S. FREEMAN

Surveyed OCT. 4 1977, by J.S.DONALDSON