


T.7S.,R.1E.,W.M.

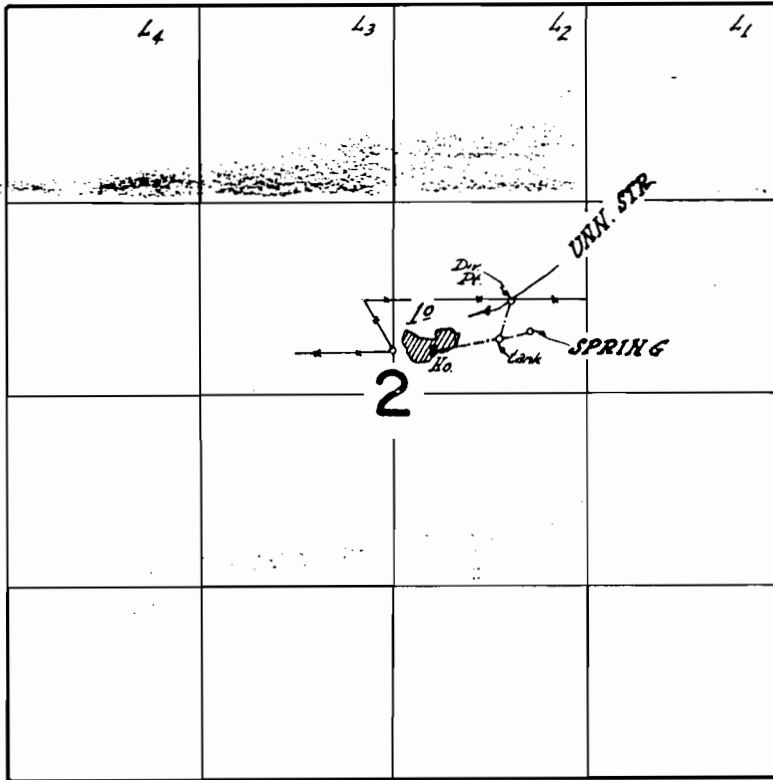

Dir Pts. loc.: Stream - 630' N. of 530' W.; Spring - 430' N. of 390' W.; both from the SE cor. SW 1/4 NE 1/4 Sec. 2.

FINAL PROOF SURVEY UNDER

Application No. 55113 Permit No. 41389
53555 Permit No. 40322
 IN NAME OF

JOHN E. & VIRGINIA A. AGAR

Surveyed Sept. 8 1977, by R. G. Mucken