


# T.7S.,R.1E.,W.M.

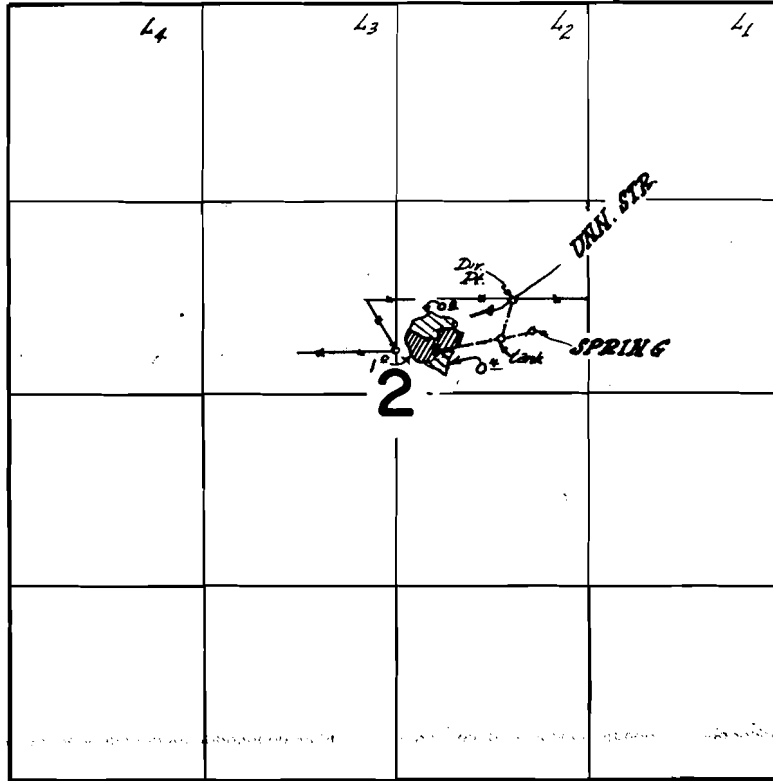


*Dir. Pts. loc.: Stream - 630'N. & 530'W.; Spring - 430'N. & 390'W.; both from the SE cor. SW 1/4 NE 1/4 Sec. 2.*

## FINAL PROOF SURVEY UNDER

57492  
55113

43232 PRIMARY   
41389 SUPPLEMENTAL 

Application No. 53555 Permit No. 40322 PRIMARY   
IN NAME OF

.....JOHN E. & VIRGINIA A. AGAR.....

Surveyed Sept. 8 1977, by R. G. Muckler  
JUNE 13 1984 BEN BISHOP