


T. 4 S. R. 10 W. W.M.

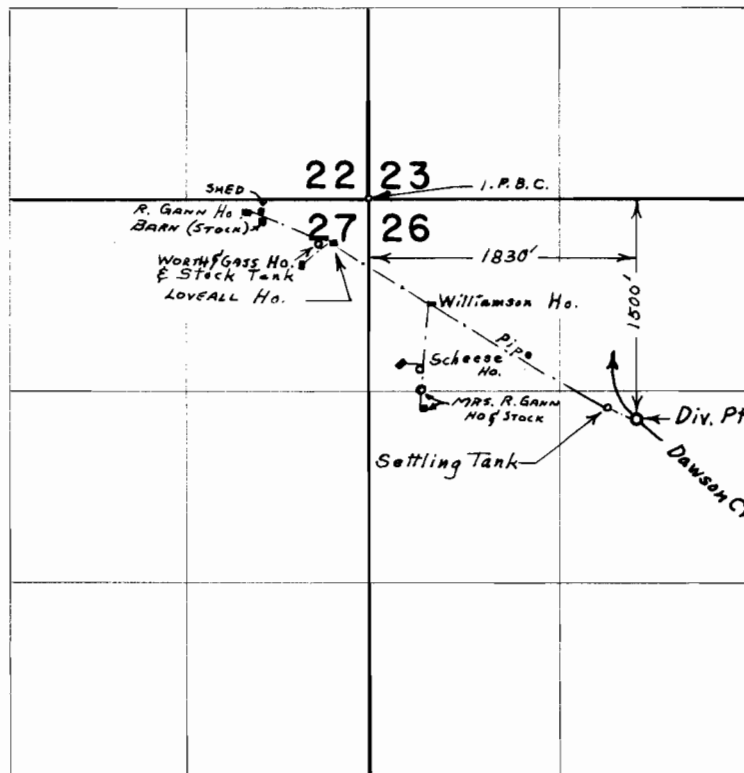

FINAL PROOF SURVEY UNDER

Application No. 42394 Permit No. 31452
IN NAME OF

Surveyed Aug. 13, 1971, by L. E. Gould
JUNE 27, 1975 L. E. GOULD