


T.1S.R.8W.W.M.

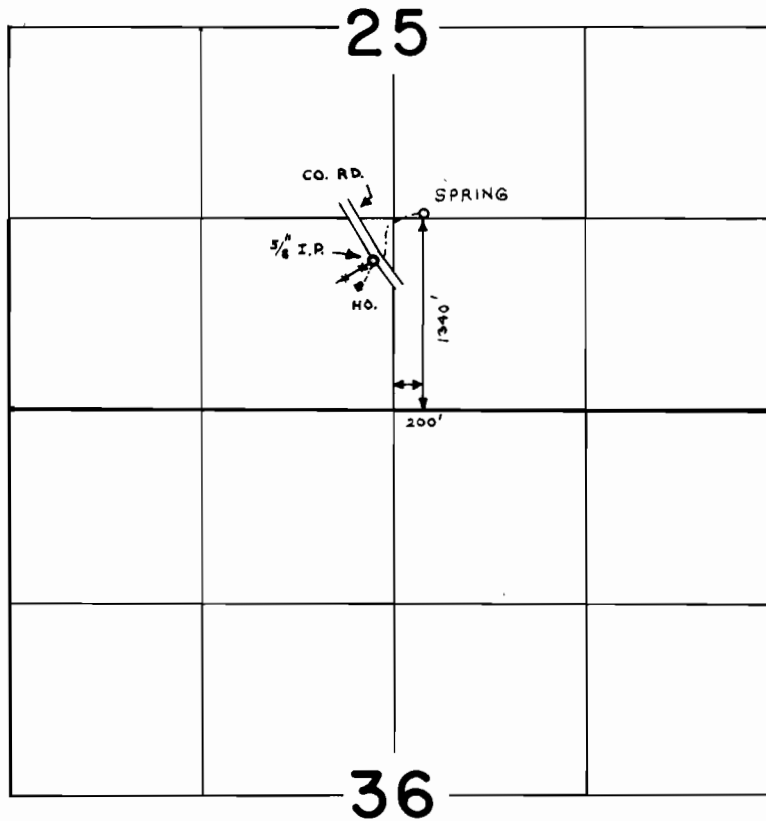

FINAL PROOF SURVEY
UNDER

Application No. 52181 Permit No. 39292
IN NAME OF

KENNETH BURCKARD

Surveyed July 27, 1976, by R.G. Mucken