


T. 3 S., R. 38 E., W.M.

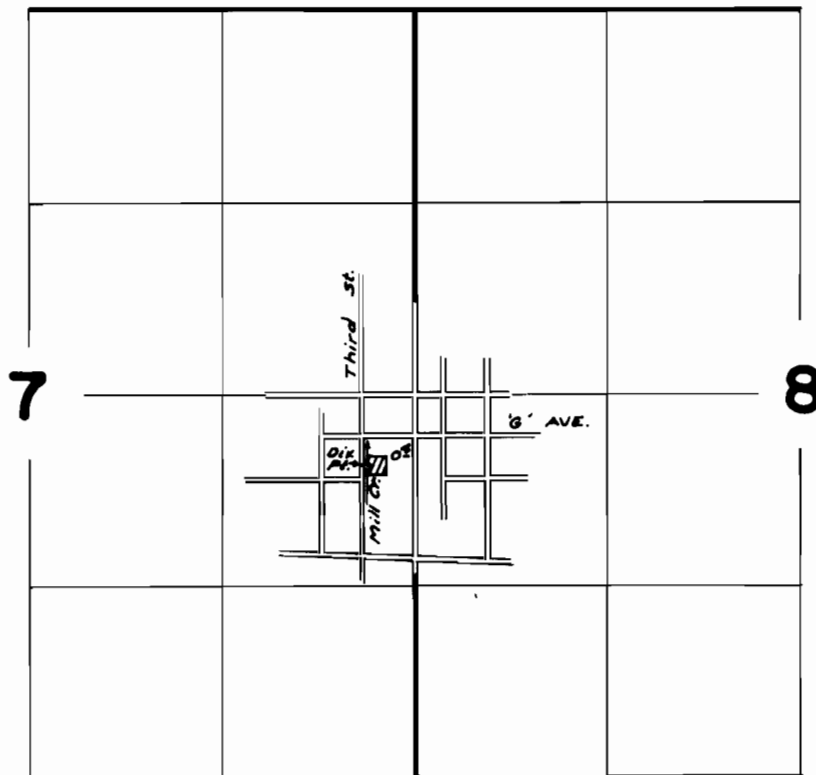

Dir. Pt. Loc.: 2150' N. of 330' W. from SE Cor. Sec. 7

FINAL PROOF SURVEY UNDER

Application No. 53665 Permit No. 40127
IN NAME OF

Frances W. Townley

Surveyed Sept 25, 1976, by D. M. Norby