


T.6N.R.43E.W.M.

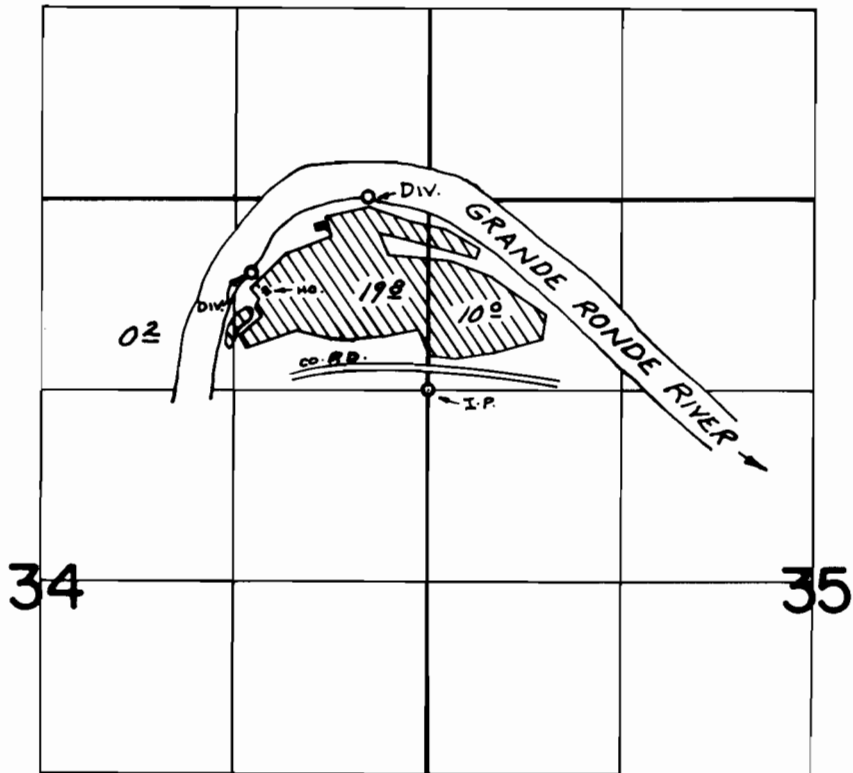

DIV. PTS. LOC: 1320' N. & 420' W ; 820' N. & 1200' W, BOTH  
FROM S. E. COR. NE 1/4 NE 1/4 SEC. 34

**FINAL PROOF SURVEY**  
UNDER

Application No. 51201... Permit No. 38689...  
IN NAME OF

.....WILLARD H. MALLORY.....

Surveyed SEPT. 23 1976., by R. MUCKEN