


T.2S.R.44E.W.M.

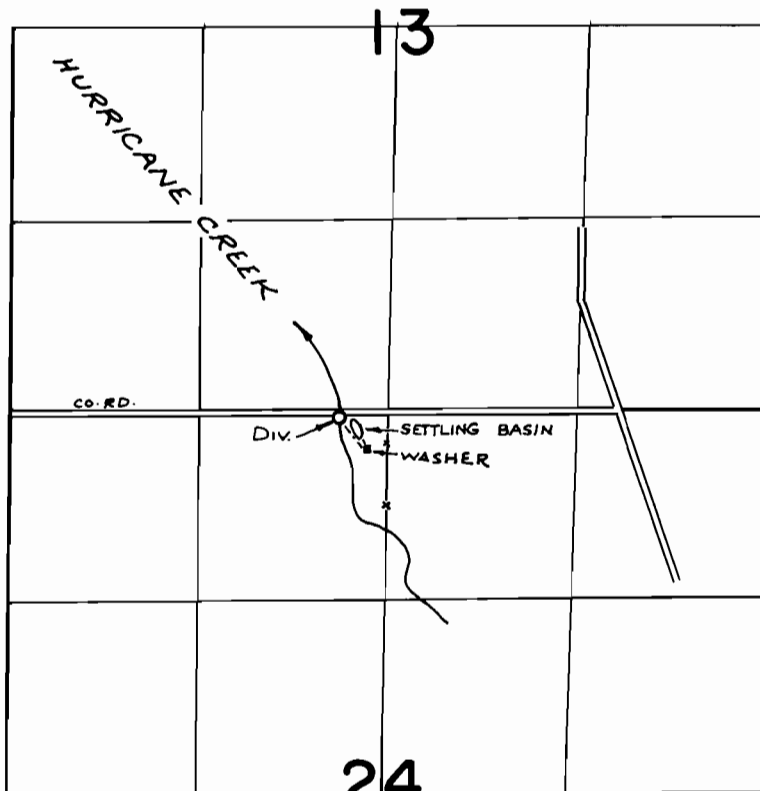

DIV. LOC: 40'S. & 320'W. FROM N $\frac{1}{4}$ COR. SEC. 24

FINAL PROOF SURVEY
UNDER

Application No. 51609 Permit No. 38926
IN NAME OF

F. E. STONE

Surveyed SEPT. 23 1976, by R. MUCKEN