


T.2S.R.44E.W.M.

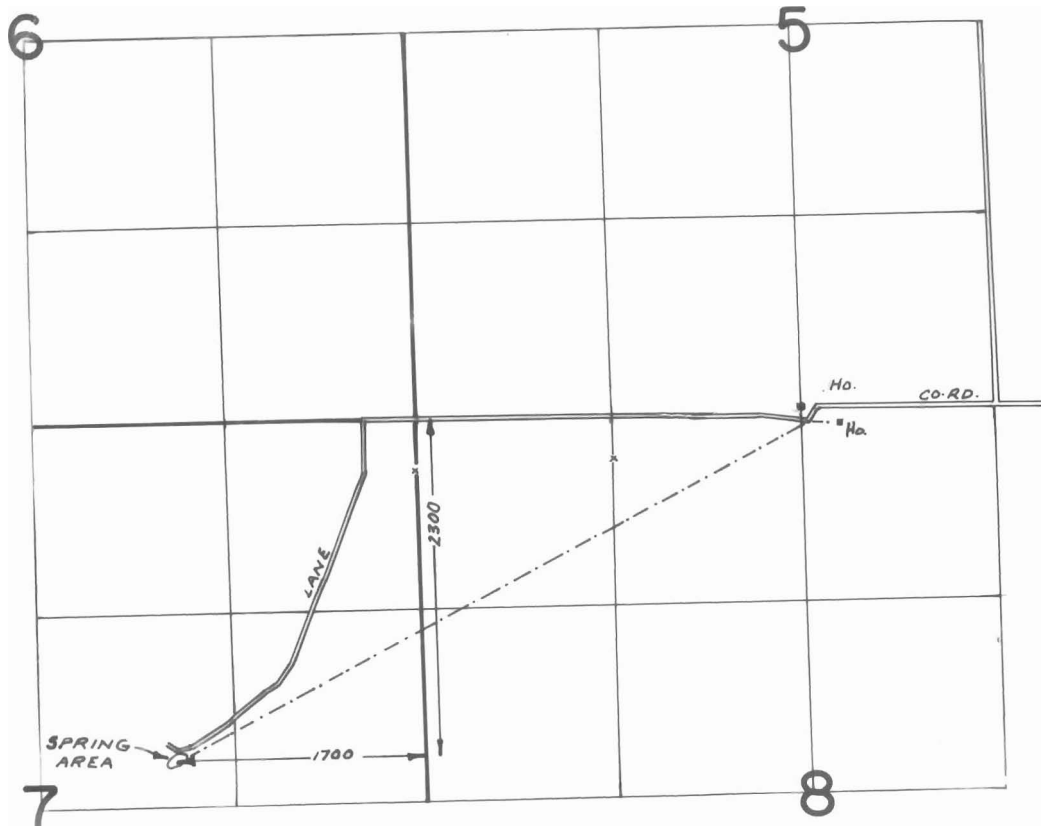

**FINAL PROOF SURVEY**  
UNDER

Application No. 52145 Permit No. 39271

IN NAME OF

*A. T. Wright*  
*Harold & Hope McLaughlin*

Surveyed SEPT. 27 1976, by R. MUCKEN.