


T. 2 S. R. 14 E. W. M.

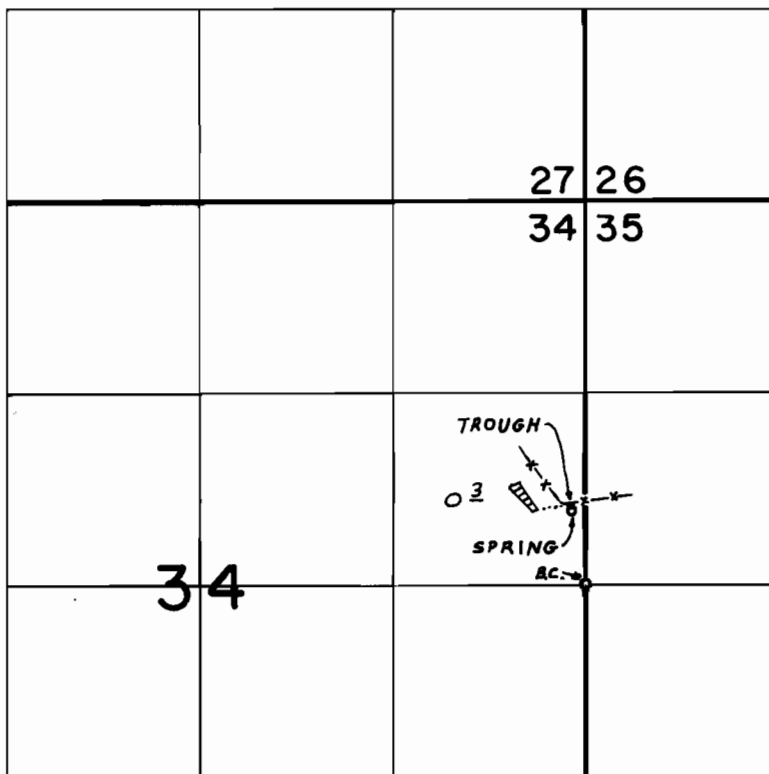

SPRING LOC. 500' N. & 100 W. FROM E. 1/4 COR. SEC. 34

FINAL PROOF SURVEY UNDER

Application No. 52449... Permit No. 37535...
IN NAME OF

.....**THOMAS W. MAY**.....

Surveyed JUN. 30, 1977, by R. G. MUCKEN.....