


RALPH W. HAZEN
3821 W. 10th. Street
The Dalles, Ore. 97058

RECEIVED
APR 16 1975
STATE ENGINEER
361

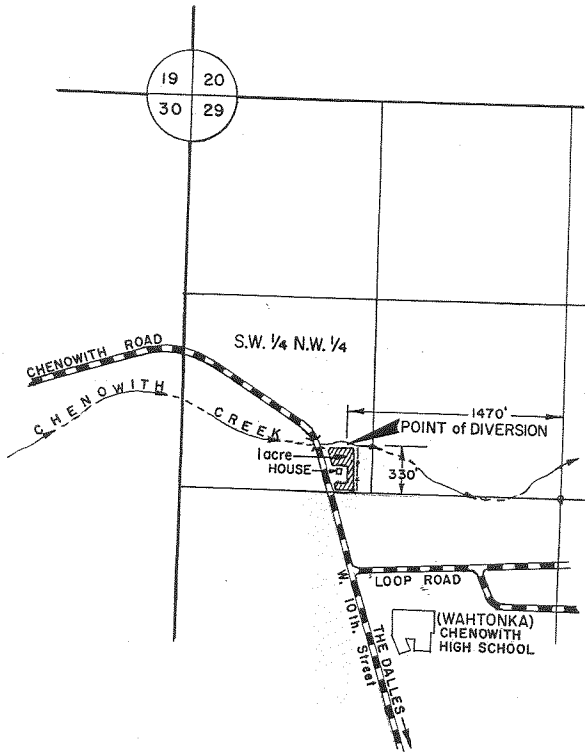

S.W. 1/4 N.W. 1/4 S. 29 T. 2 N. R. 13 E. W.M.

Scale 1"=660'

Am. San. Gen. No. 53002
40007