


T.2S.R.2W.W.M.

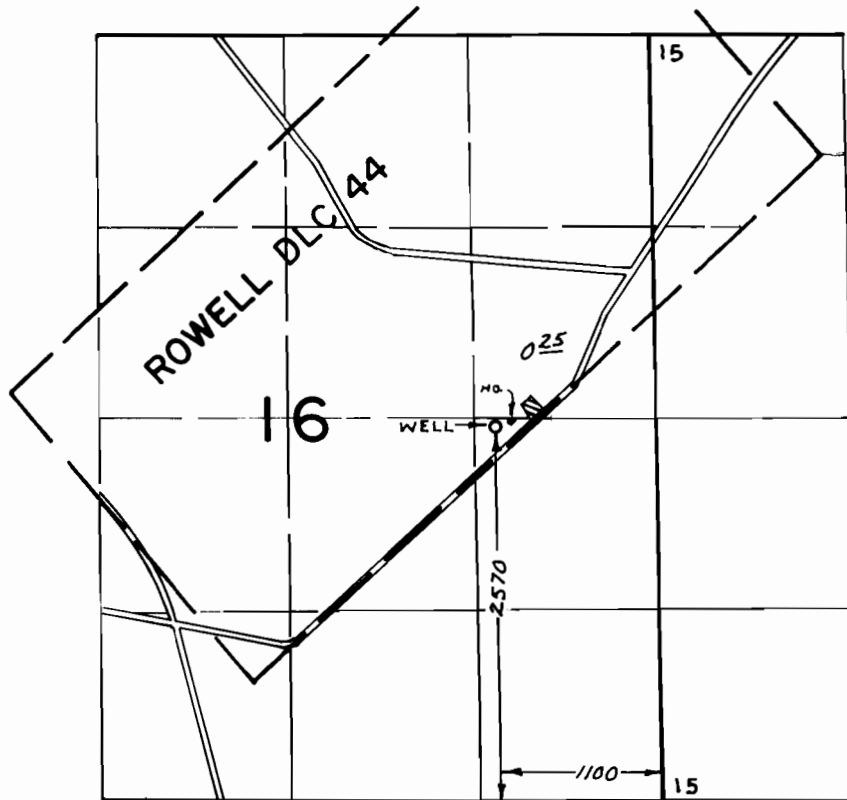

FINAL PROOF SURVEY
UNDER

Application No. G-7084 Permit No. G-6373
IN NAME OF

JERRY FALTY'S

Surveyed SEPT. 8, 1976, by R. MUCKEN