


T. 1N. R. 4W., W.M.

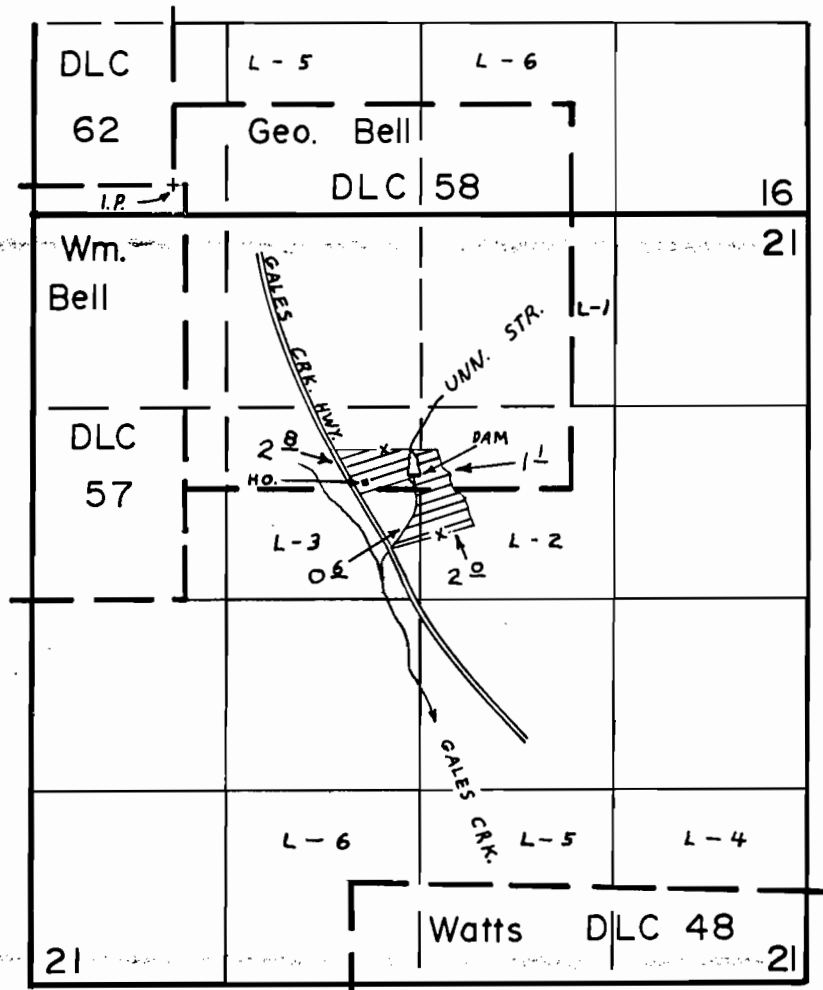

DAM LOC. 1790' S. + 50' W. FROM N. 1/4 COR. SEC. 21

FINAL PROOF SURVEY UNDER

R-47234 R-5679
 Application No. 47550 Permit No. 35405
 IN NAME OF

RALPH HUTCHENS

Surveyed NOV. 9, 1977, by B.G. MUCKEN