


# T. 1N. R. 3W. W.M.

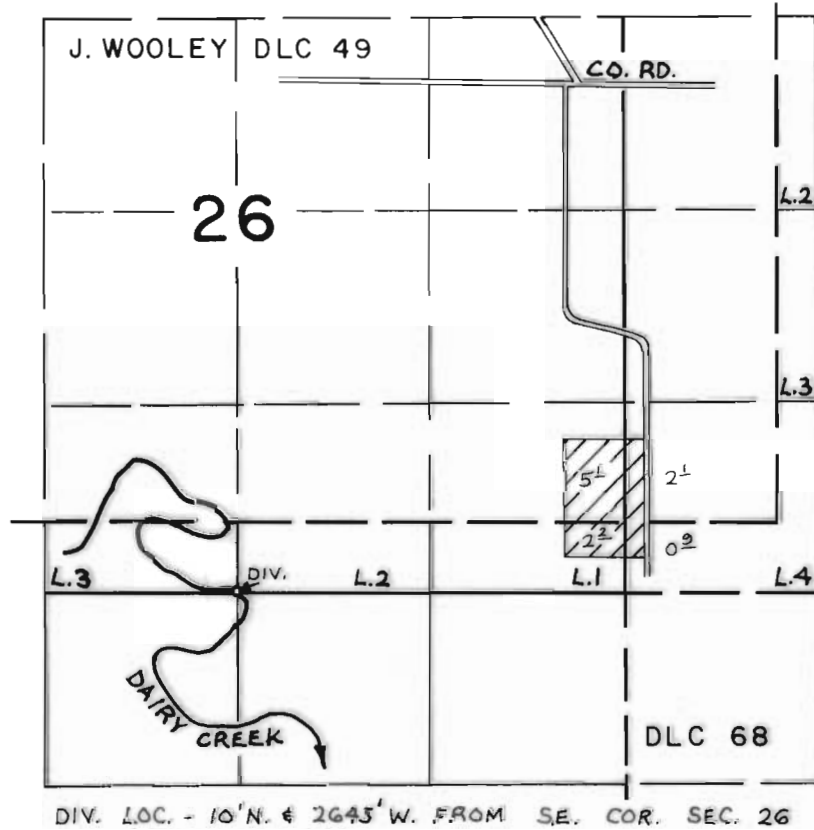

## FINAL PROOF SURVEY UNDER

Application No. 48120 Permit No. 36134  
IN NAME OF

RON TANKERSLEY

Surveyed May 21 1976, by R.G. Mucken