


# T.1N. R.2W. W.M.

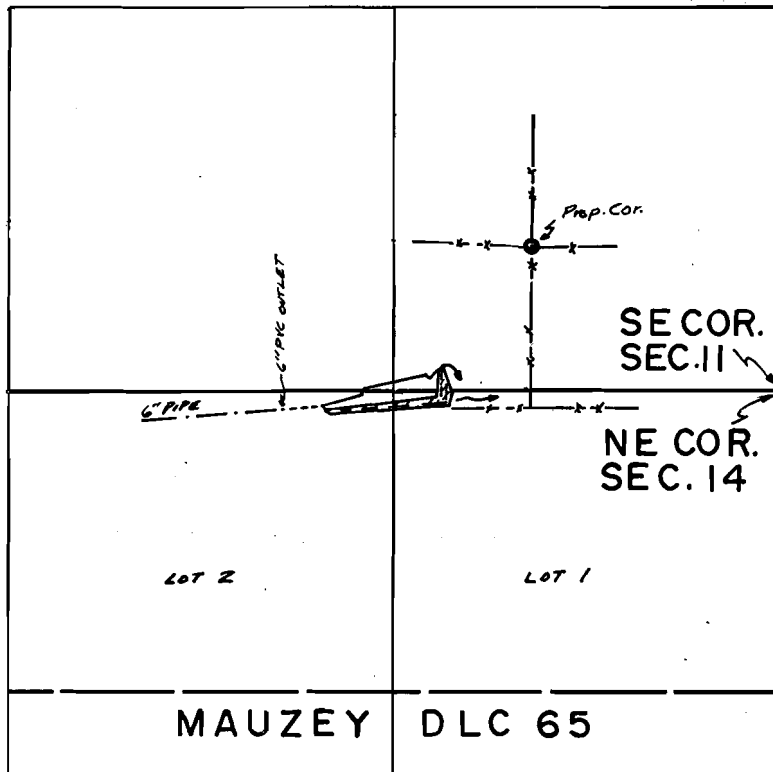

Scale - 1" = 660'

## FINAL PROOF SURVEY UNDER

R-49683 R-6040  
Application No. 49798 Permit No. 37268  
IN NAME OF

L. W. HEMBREE

Surveyed 7-21 1977, by S. C. BROWN