


T.2S. R.2 W., W.M.

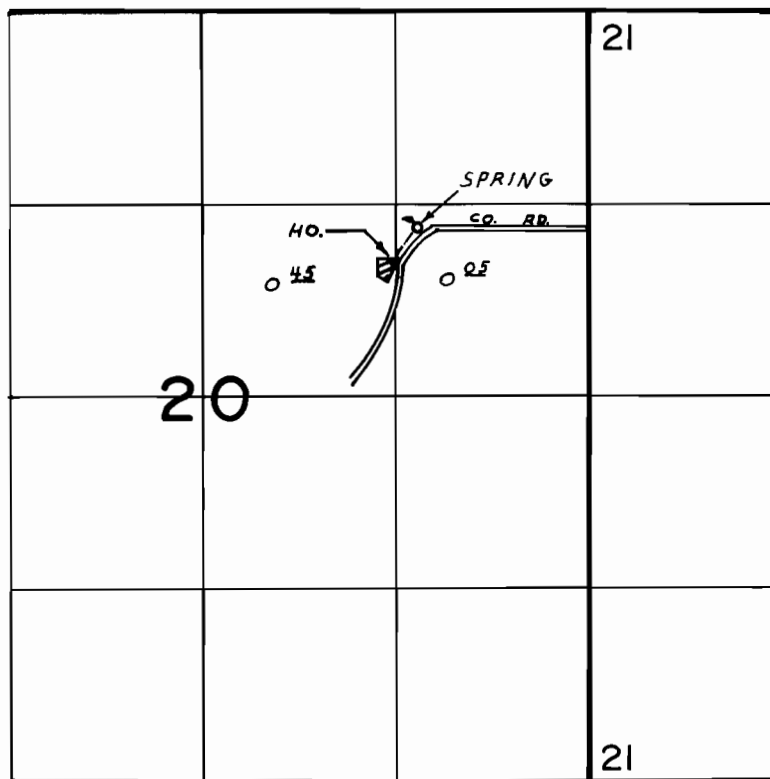

SPRING LOC. 1160' N. & 1170' W. FROM E. 1/4 COR. SEC. 20

FINAL PROOF SURVEY
UNDER

Application No. 52040.. Permit No. 39219....
IN NAME OF

CHARLES A. HAYNES

Surveyed SEP. 28, 1977, by R.G. MUCKEN