


T.1S.R.5W., W.M.

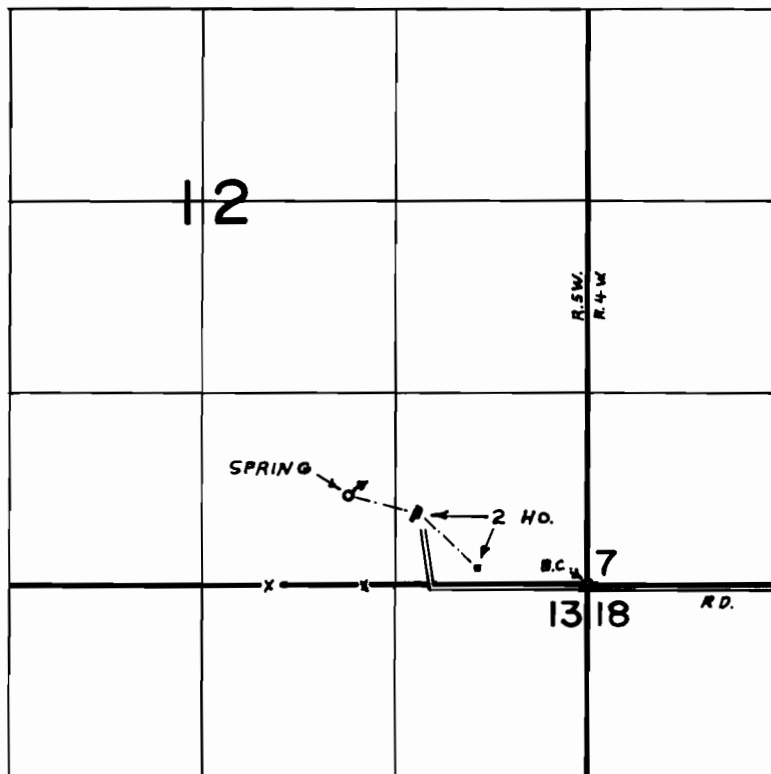

SPRING LOC. 610' N. & 1640' W. FROM S.E. COR. SEC. 12

FINAL PROOF SURVEY
UNDER

Application No. 52658.... Permit No. 39682....
IN NAME OF

...WALTER & JULIA EVANS.....

Surveyed NOV...7,... 1977, by R.G. MUCKEN....