


T. 3 S., R. 5 W., W.M.

SECTION 29

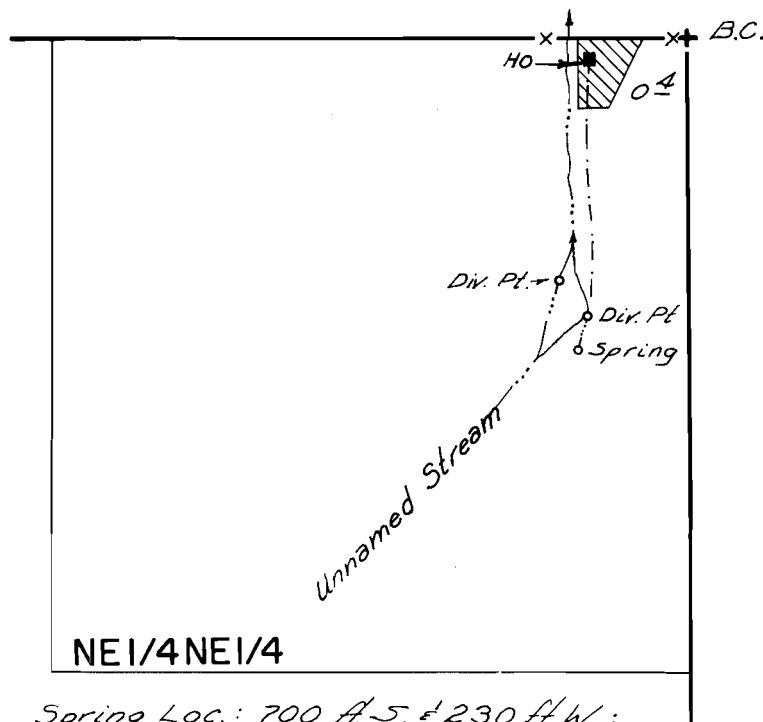

Spring Loc.: 700 ft. S. & 230 ft. W.;
Div. Pts Loc.: #1 - 580 ft. S. & 210 ft. W.;
#2 - 500 ft. S. & 270 ft. W.; All from
NE. Corner Sec. 29

SCALE 1" = 400'

FINAL PROOF SURVEY
UNDER

Application No. 50326 Permit No. 37995
IN NAME OF

Rex W. Brown

Surveyed June 3, 1976 by L. H. Nunn

PTS-1976-P *LB*