


T.5S.R.3W.W.M.

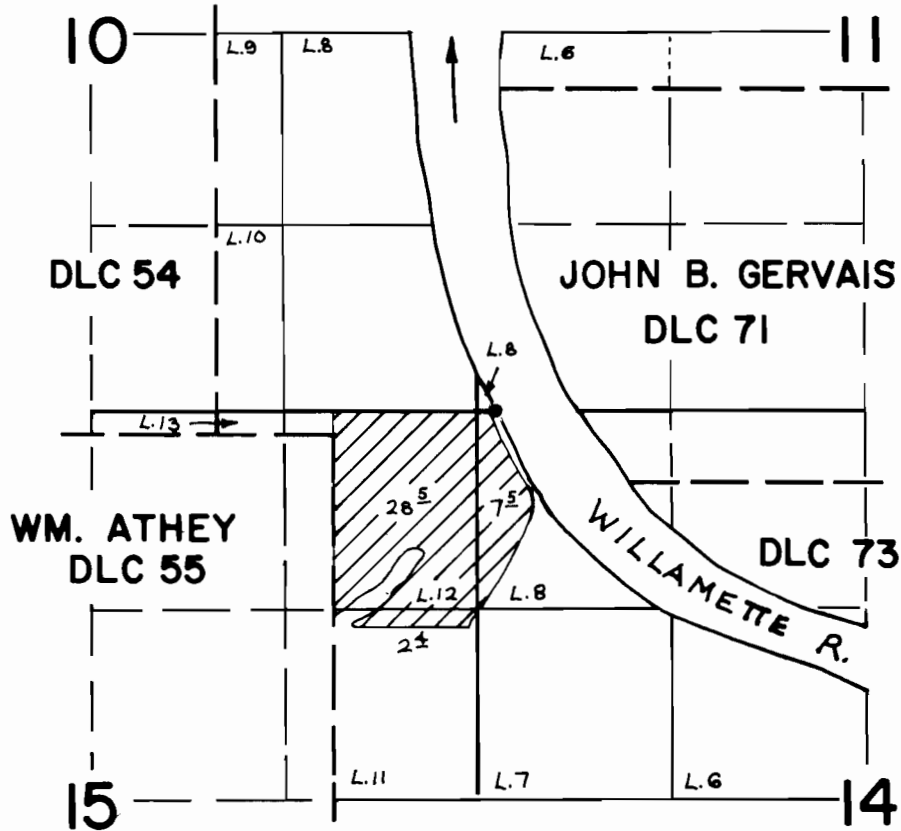

DIV. PT. LOC. -130' E. FROM N.E. CORNER SEC. 15

FINAL PROOF SURVEY
UNDER

Application No. 51642 Permit No. 38942
IN NAME OF

PETER N. EDIGER

Surveyed June 7, 1976, by R.G. Mucken