


T.2S., R.4W., W.M.

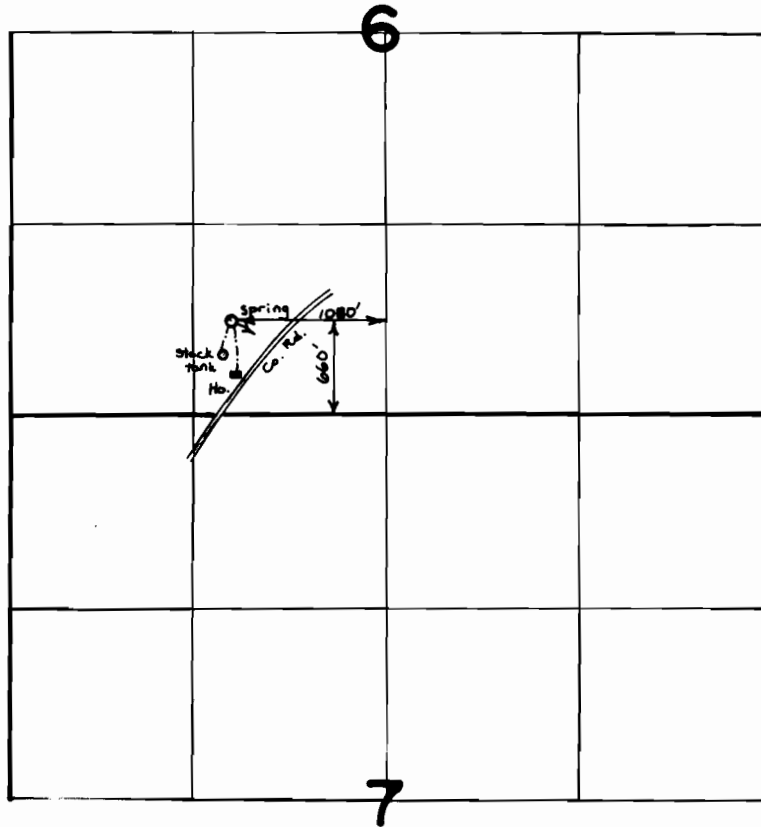

**FINAL PROOF SURVEY**  
UNDER

Application No. 53009 Permit No. 40011  
IN NAME OF

DANIEL A. & SHIRLEY GRAHAM

Surveyed AUG. 4 1976, by L. NUNN