


T.2S., R.3-4W., W.M.

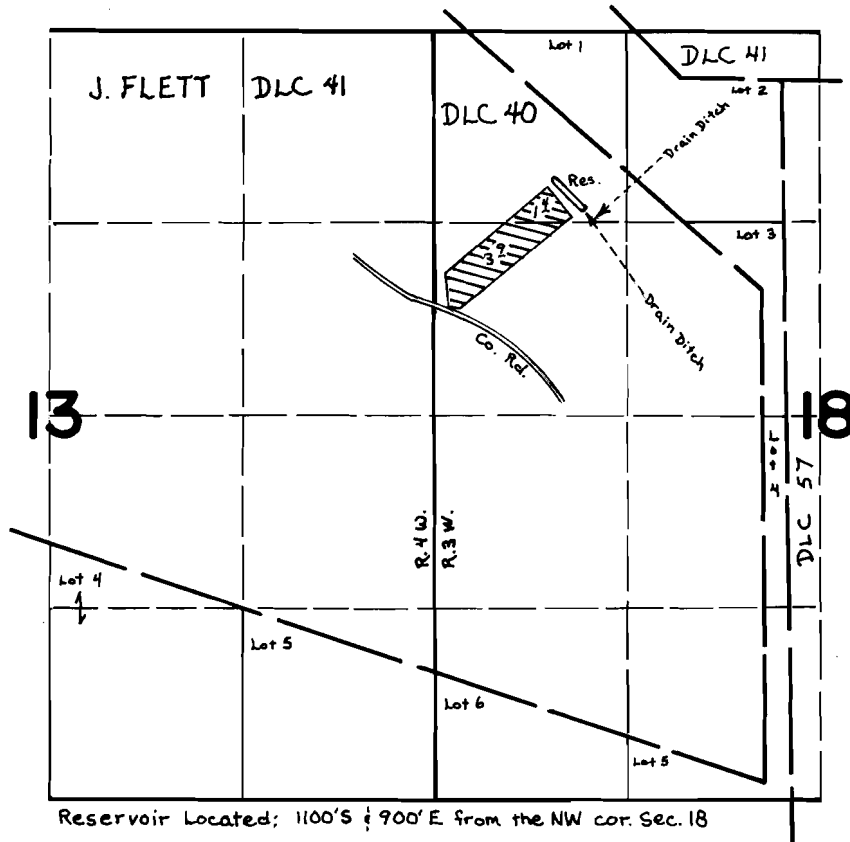

FINAL PROOF SURVEY UNDER

R-53327 R-6332
Application No. 53328 Permit No. 39570
IN NAME OF

FREDE D. BIDSTRUP

Surveyed MAR. 30 1976, by L. H. NUNN