


T.2S., R.4W., W.M.

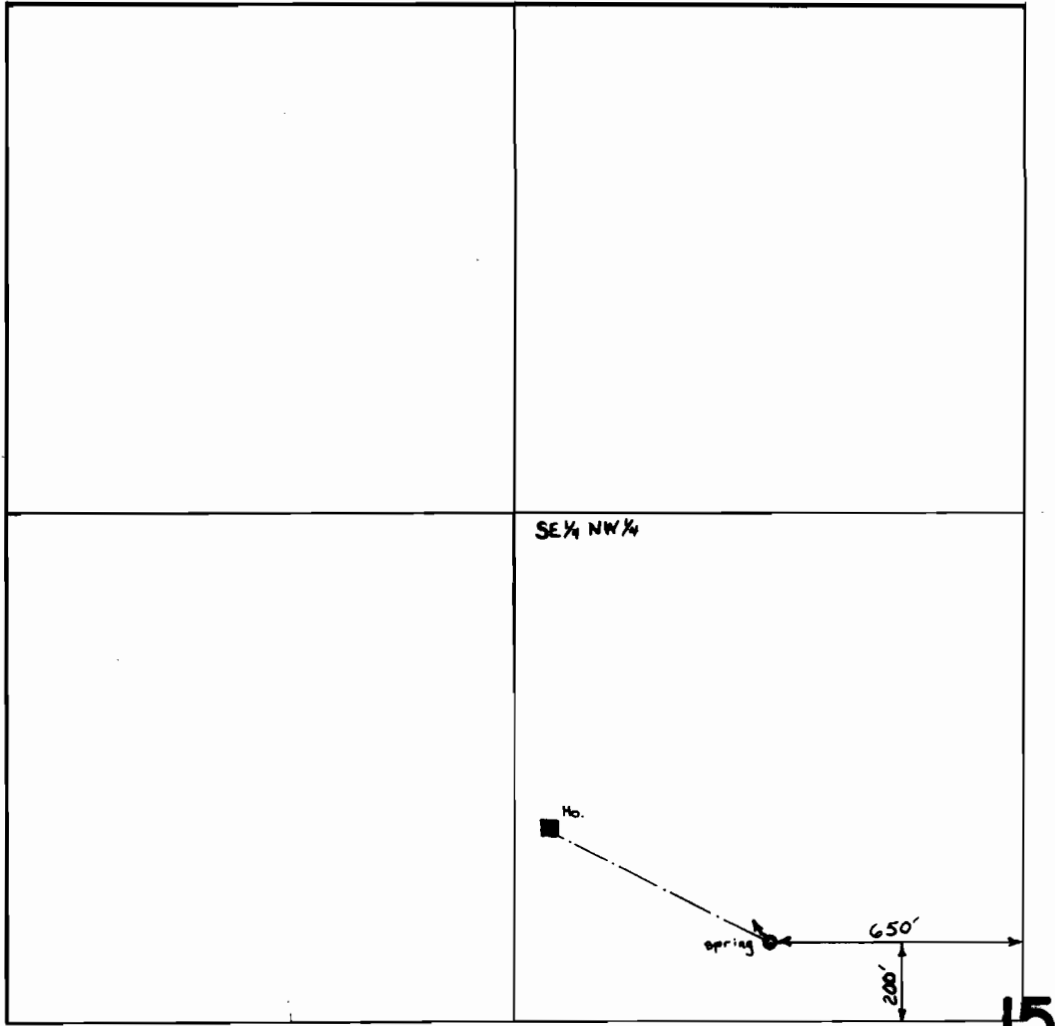

SCALE: 1" = 500'

FINAL PROOF SURVEY
UNDER

Application No. 53675 Permit No. 40133
IN NAME OF

HOWARD A. & DORIS L. MICHAELIS

Surveyed AUG. 5 1976, by L. NUNN