




T 38 S, R 19 E, W.M.

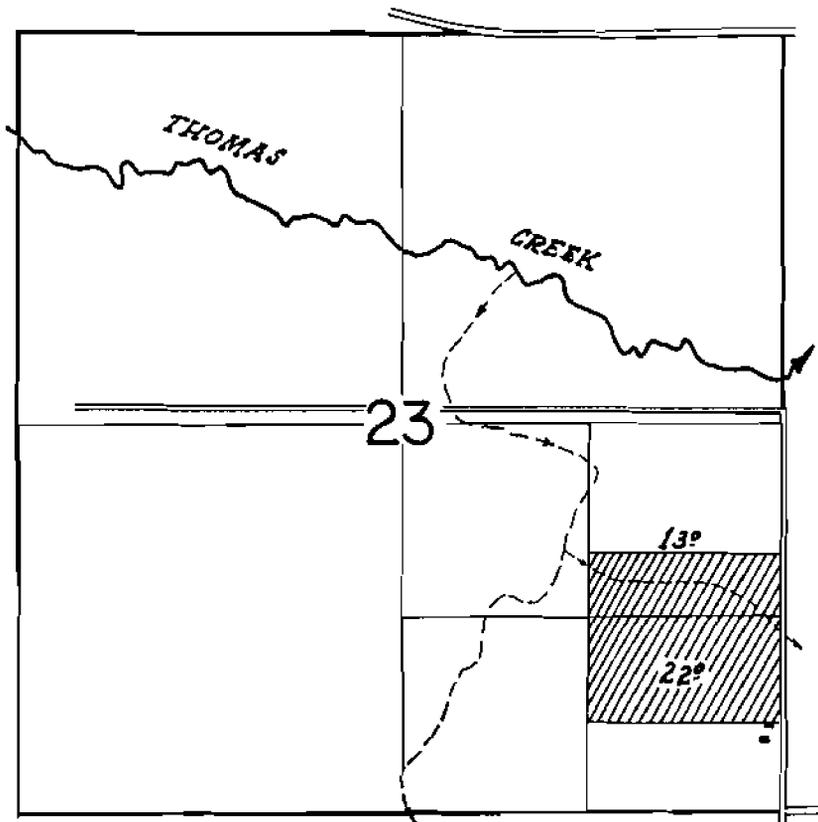

T 38 S, R 19 E, W.M.

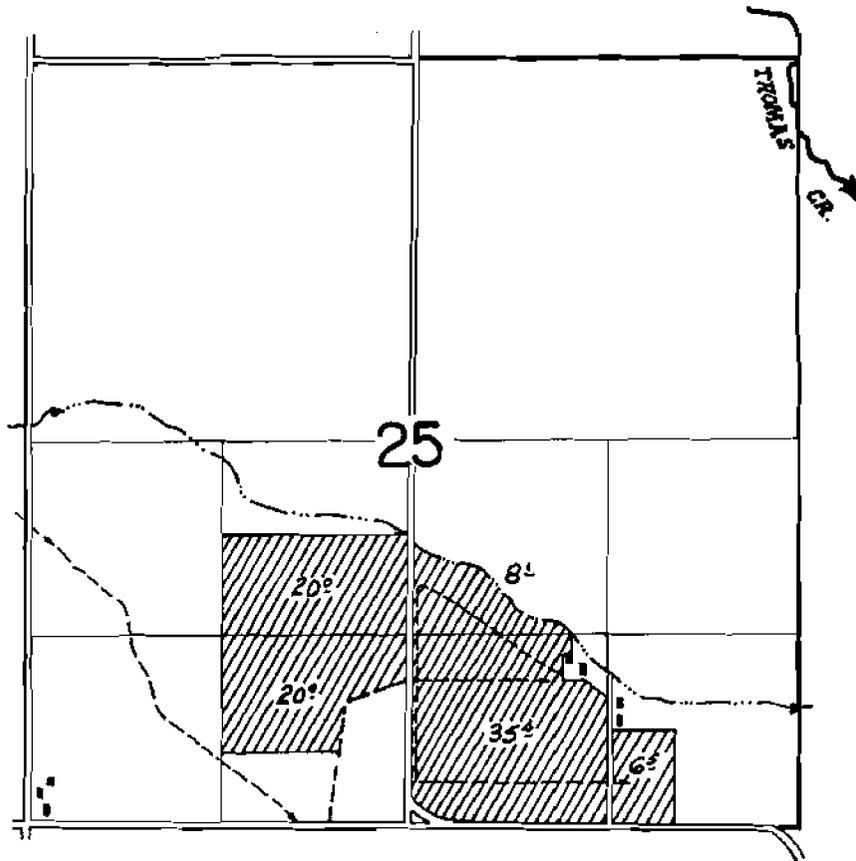


T 38 S, R 19 E, W.M.

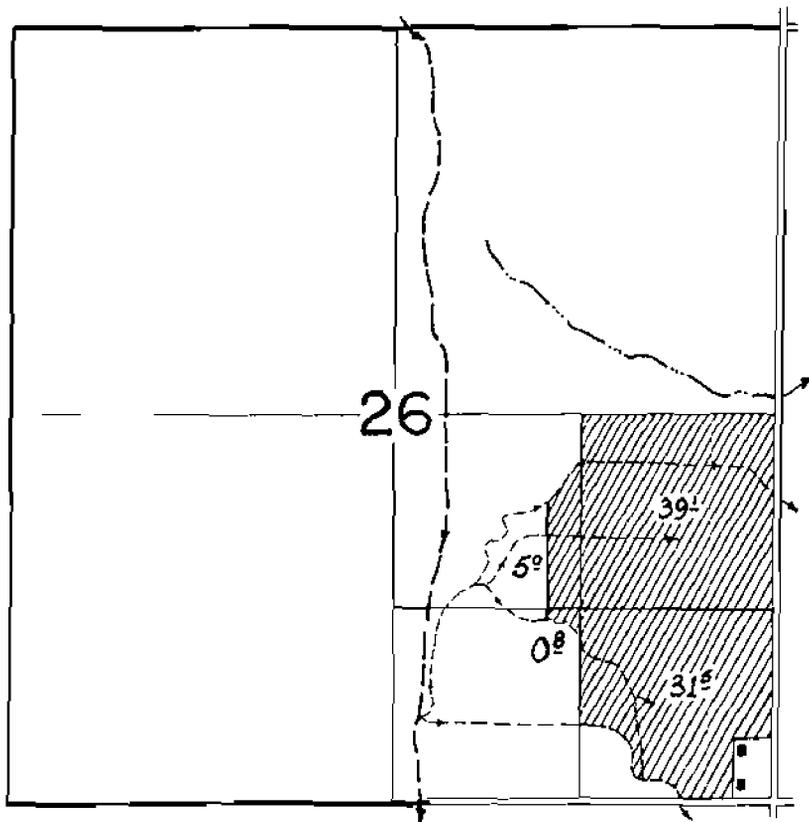







T 38 S, R 20 E, W.M.

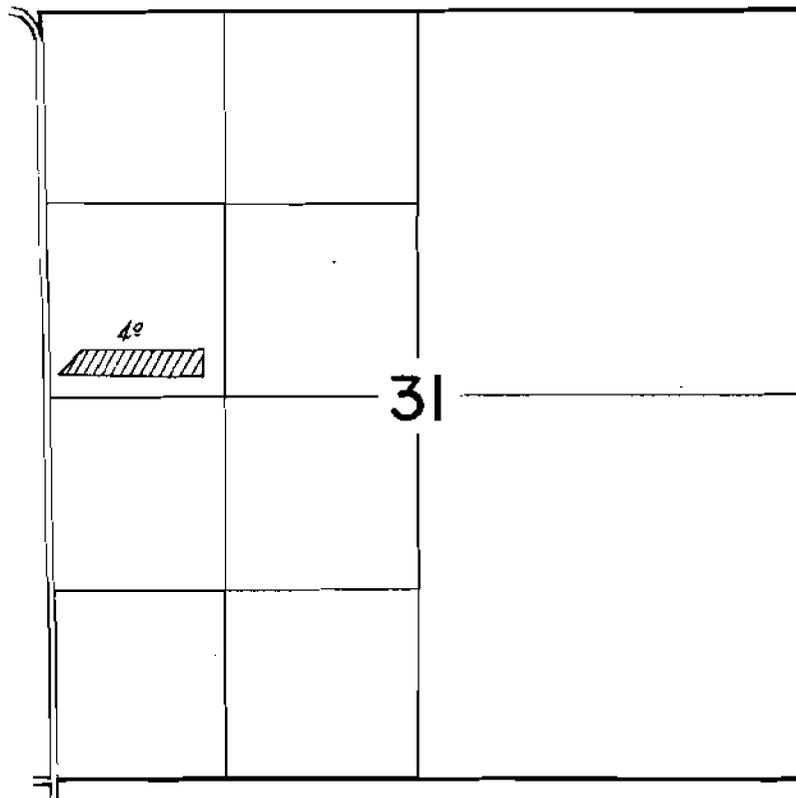


T 39 S, R 18 E, W.M.

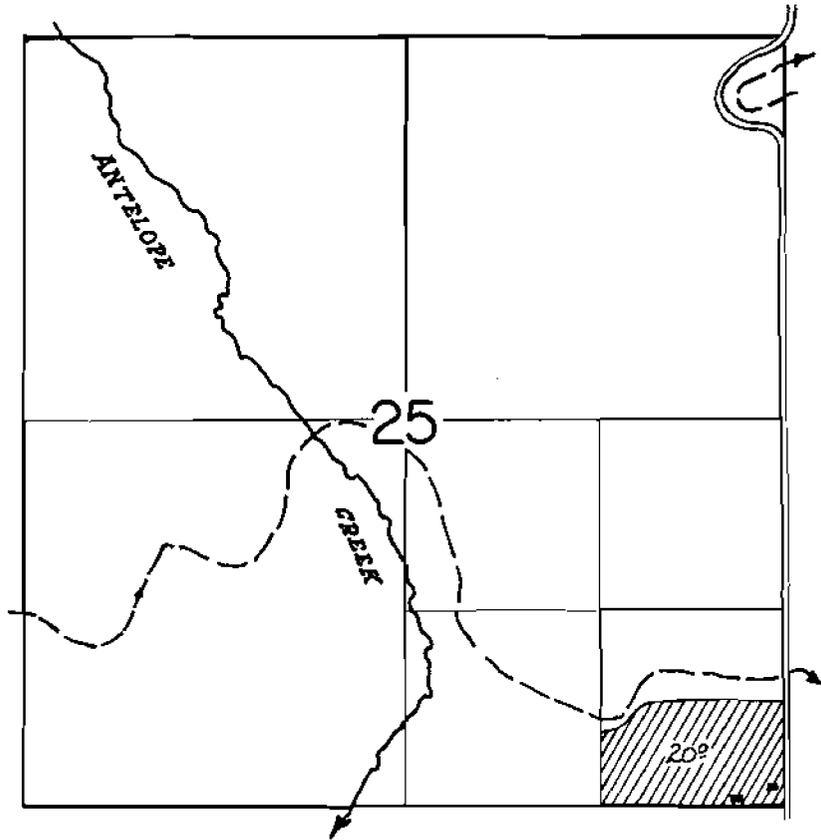


T 39 S, R 18 E, W.M.

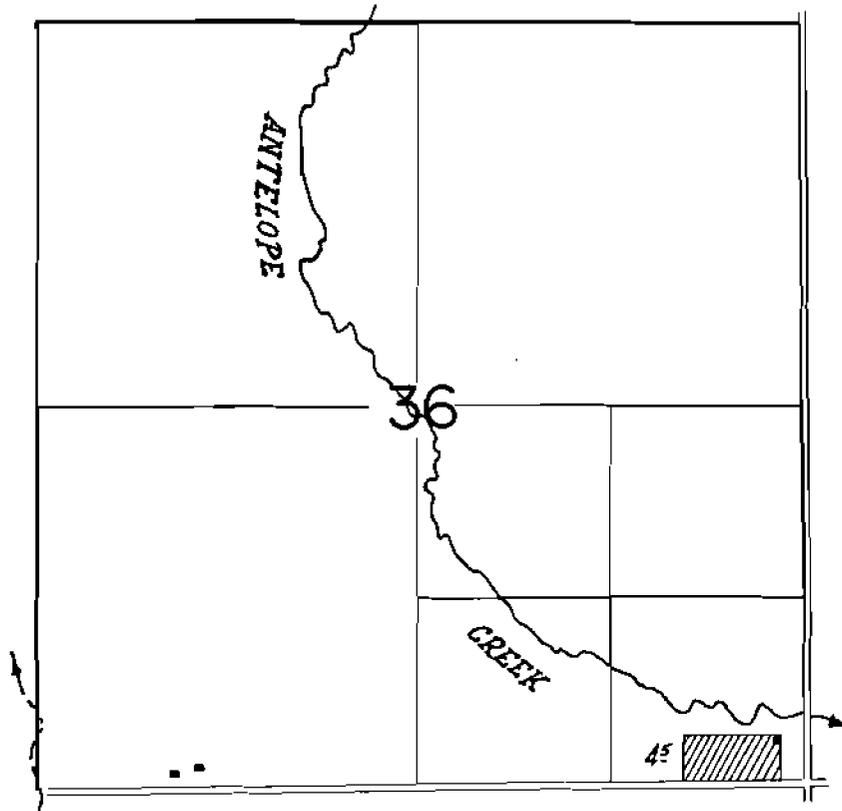


T 39 S, R 19 E, W.M.

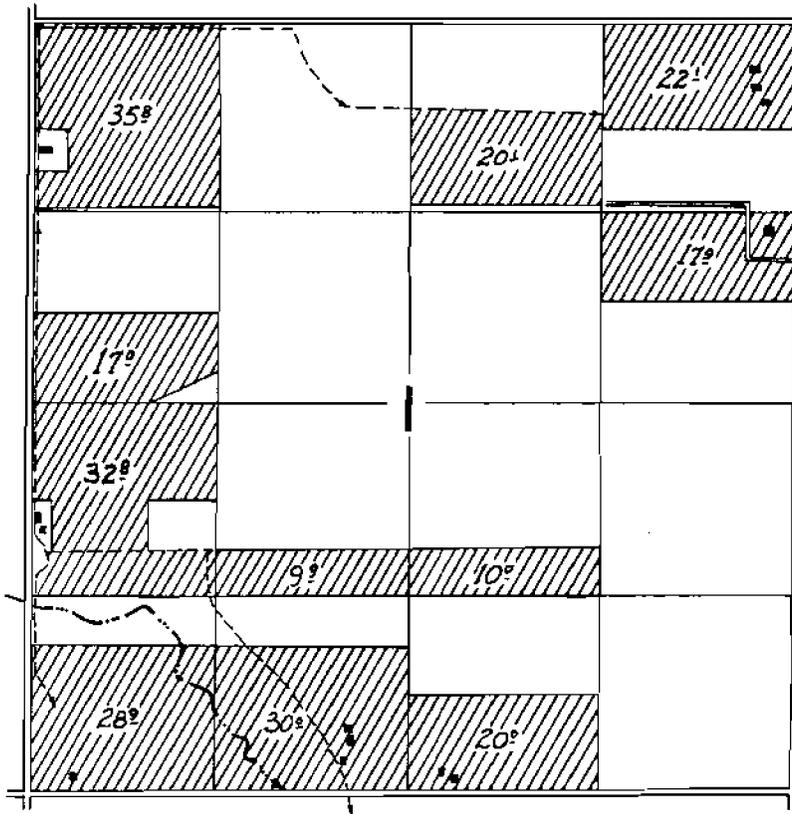


T 39 S, R 19 E, W.M.

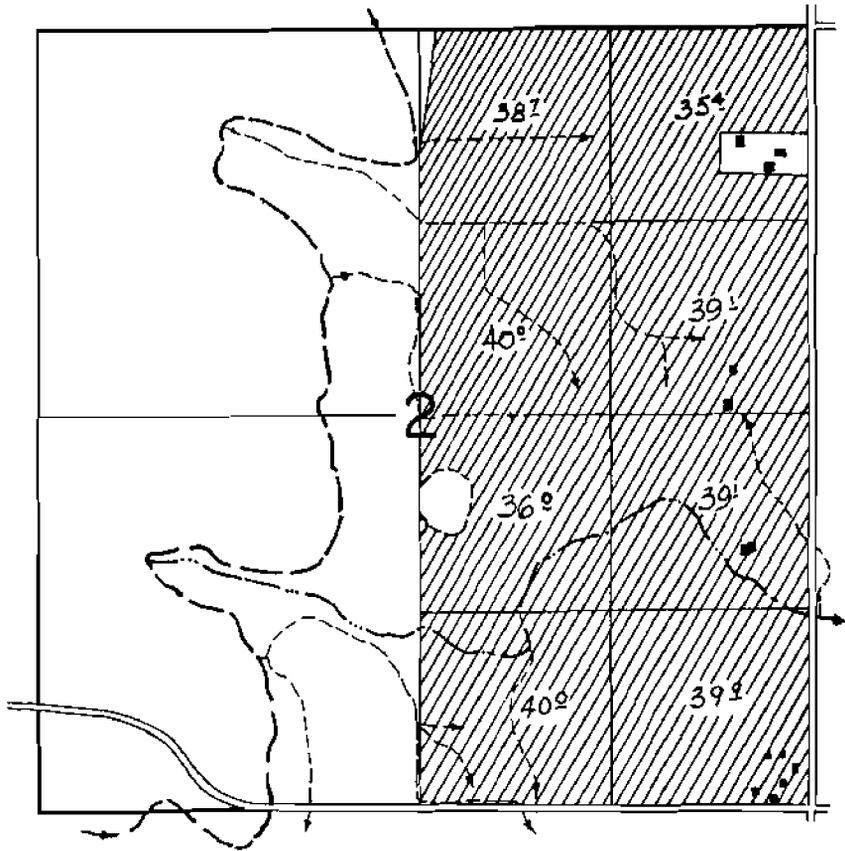


T 39 S, R 19 E, W.M.

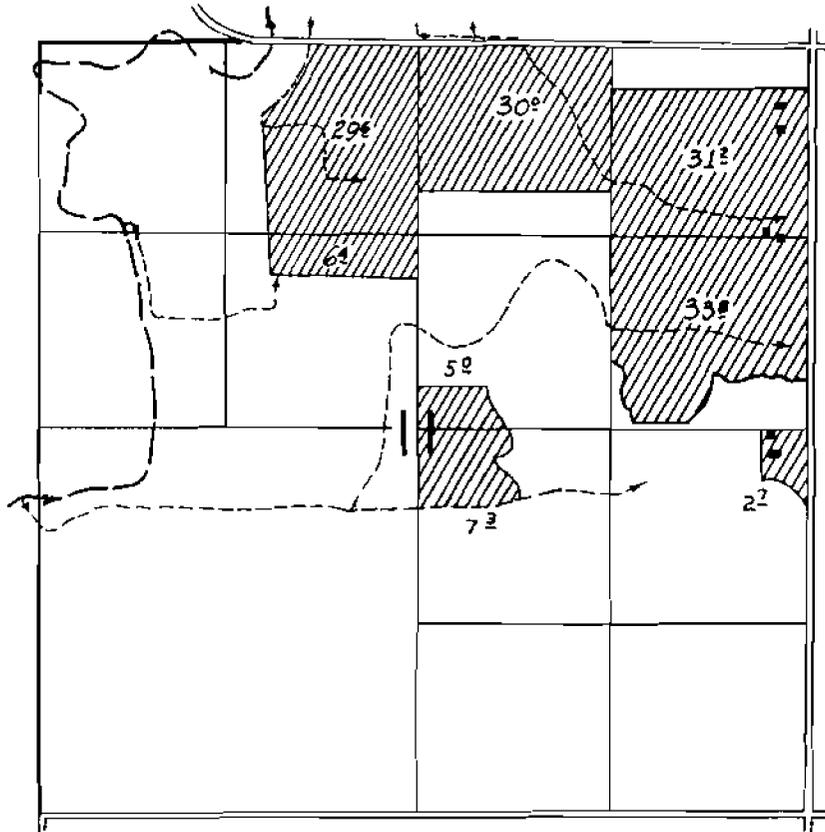


T 39 S, R 19 E, W.M.

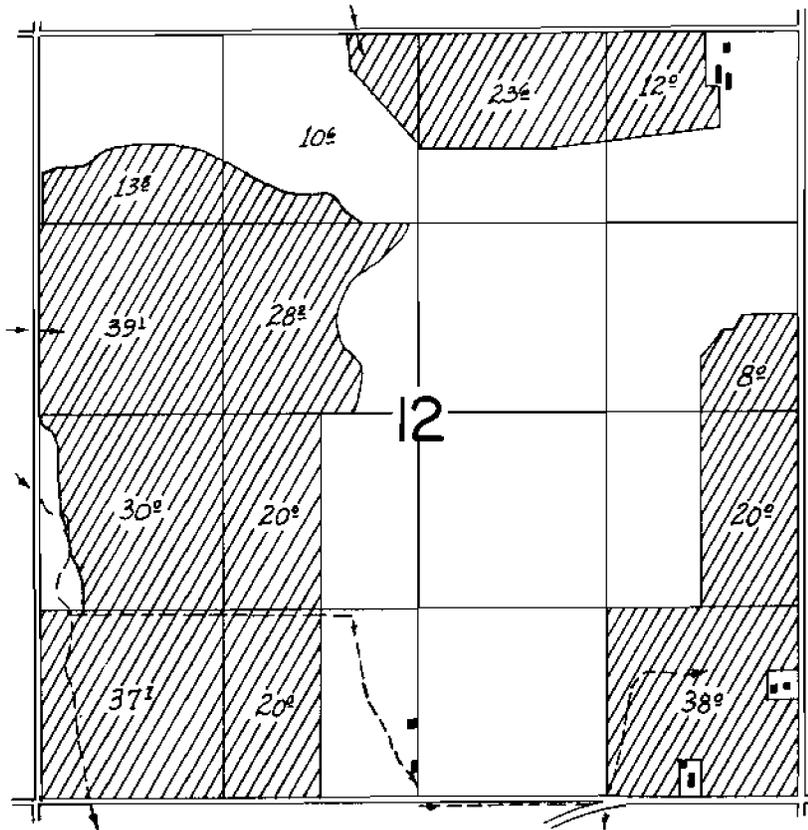


T 39 S, R 19 E, W.M.

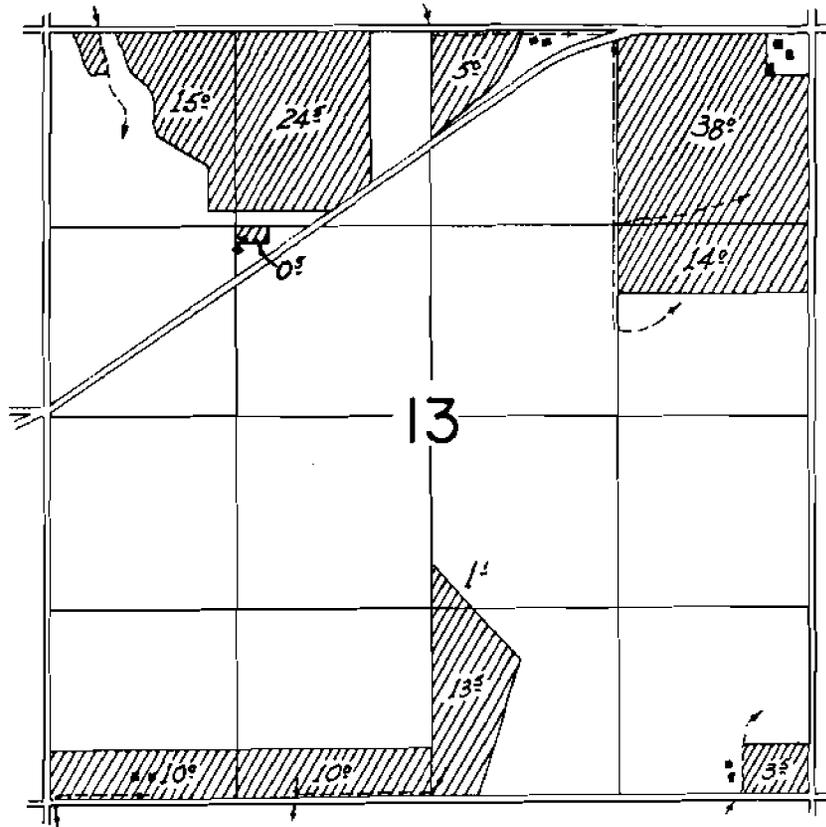


T 39 S, R 19 E, W.M.

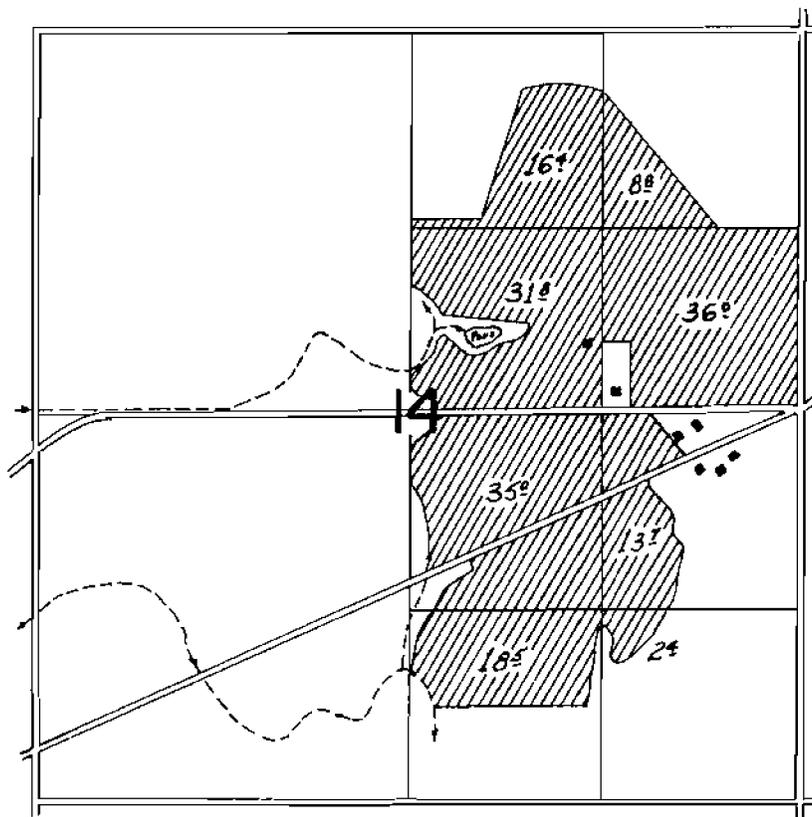


T 39 S, R 19 E, W.M.

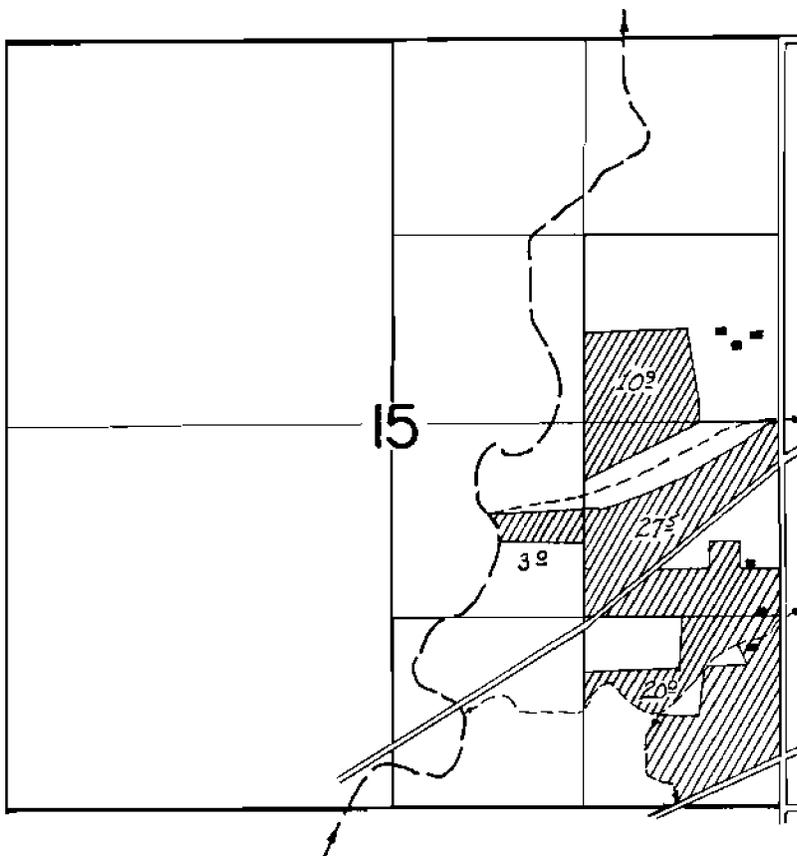


T 39 S, R 19 E, W.M.

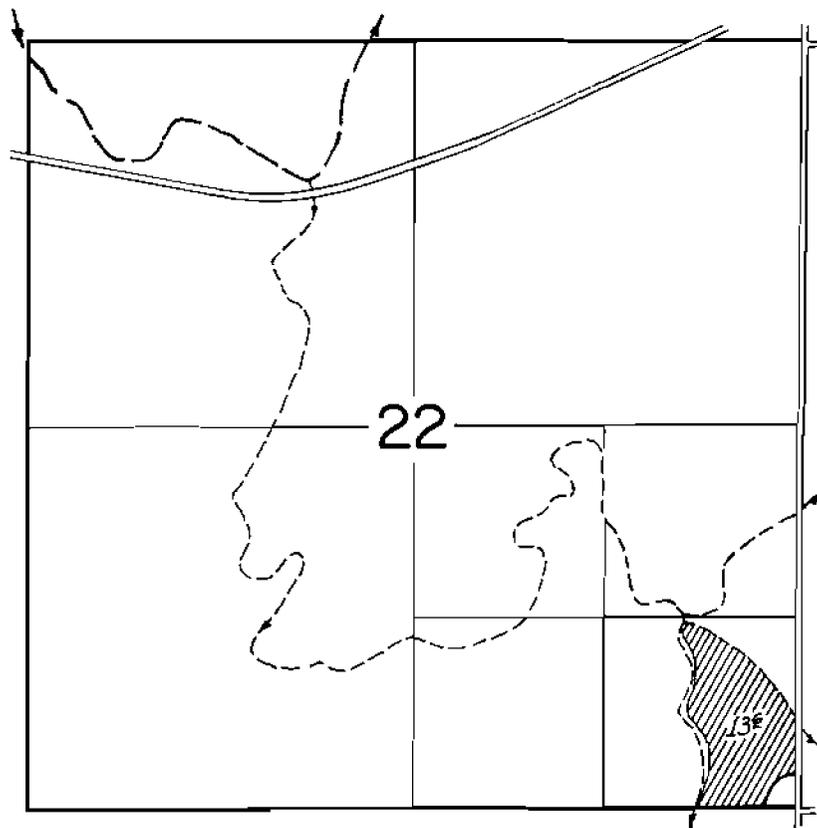


T 39 S, R 19 E, W.M.

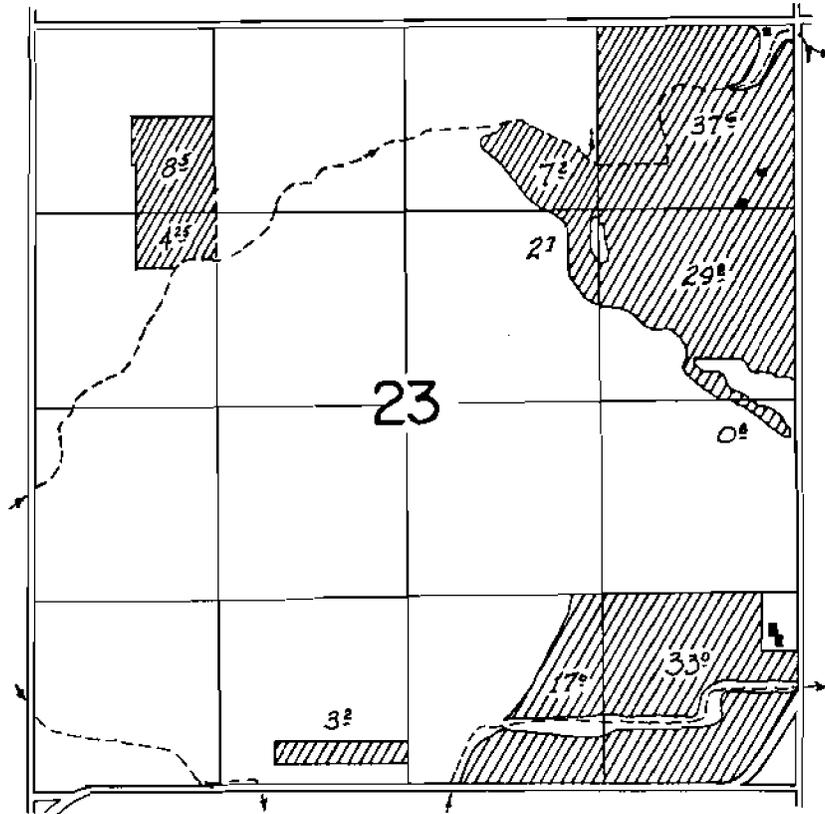


T 39 S, R 19 E, W.M.

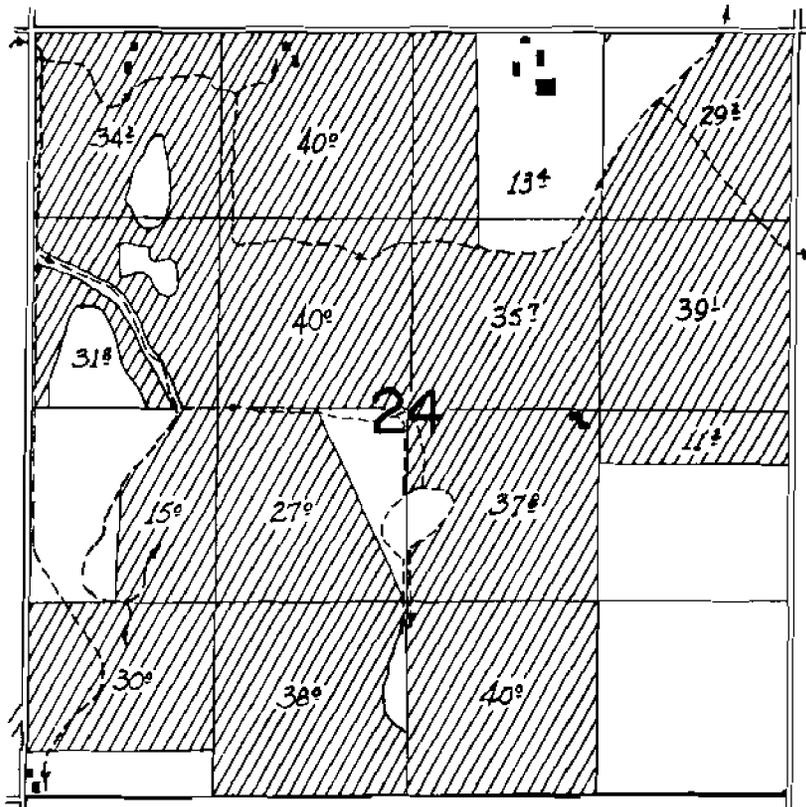


T 39 S, R 19 E, W.M.

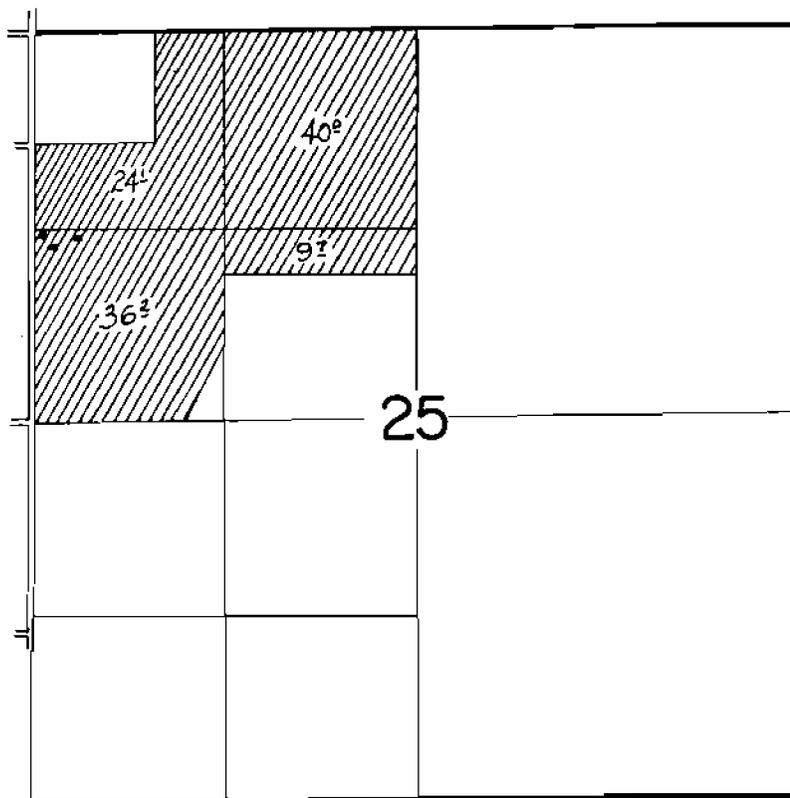


T 39 S, R 19 E, W.M.

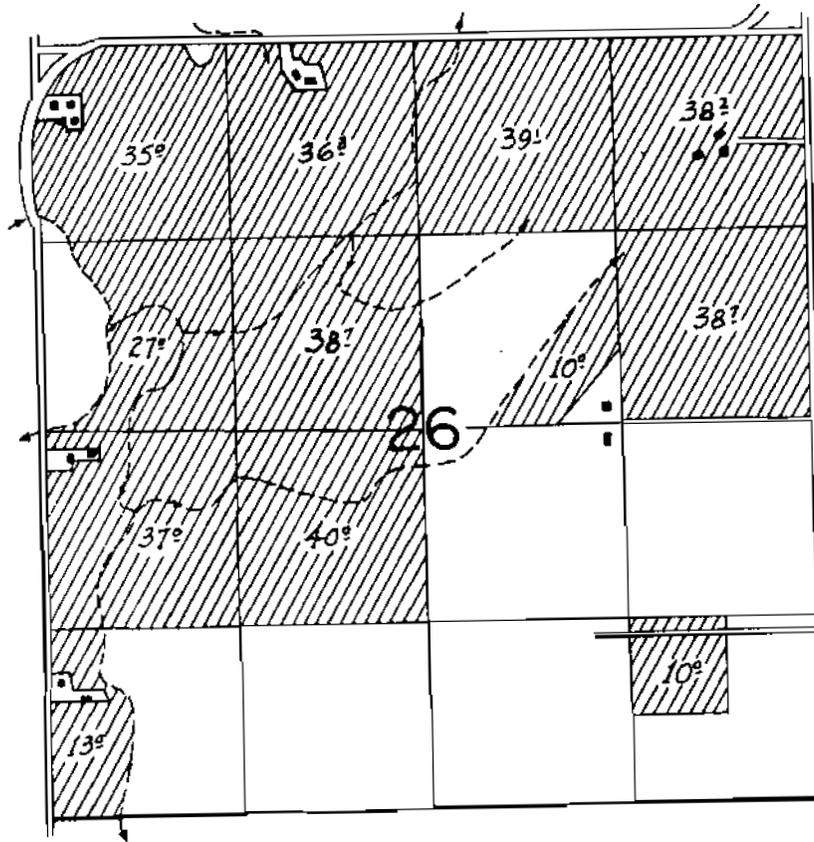


T 39 S, R 19 E, W.M.

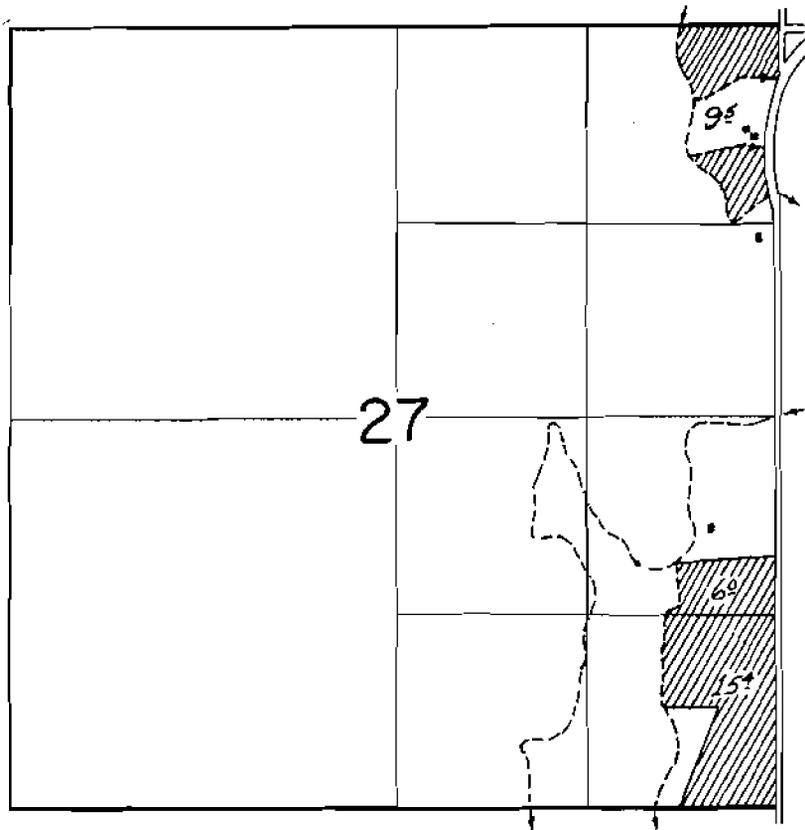

T 39 S, R 19 E, W.M.

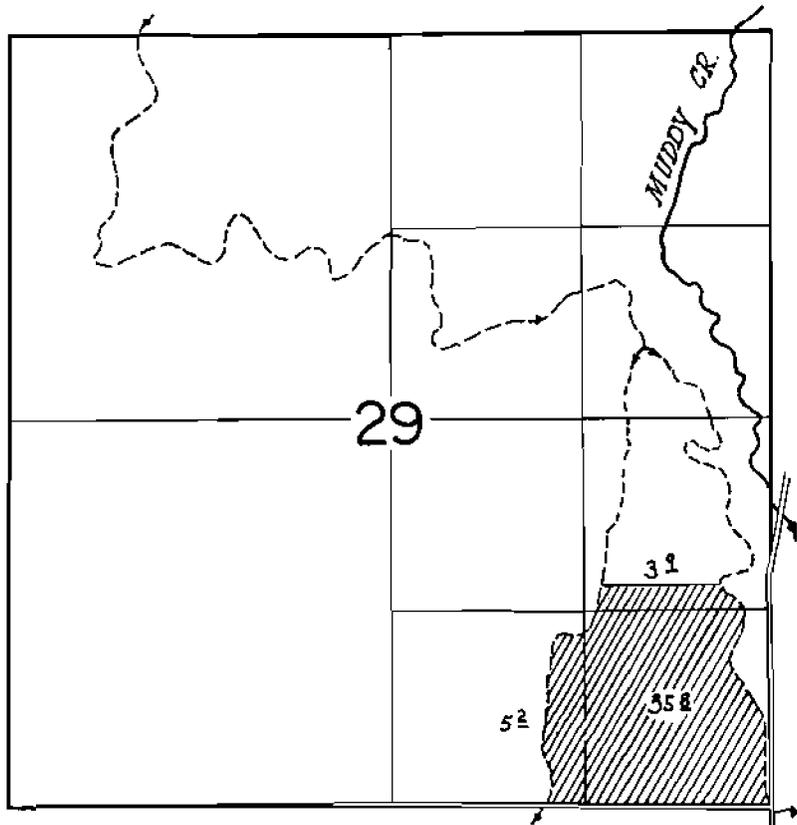


T 39 S, R 19 E, W.M.

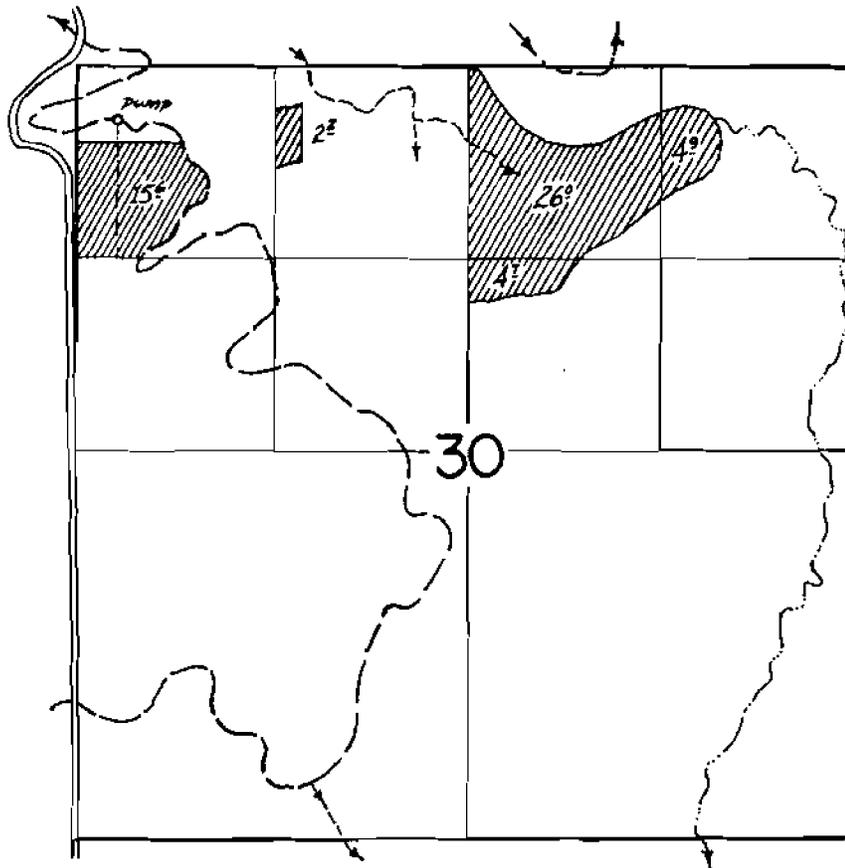





T 39 S, R 19 E, W.M.

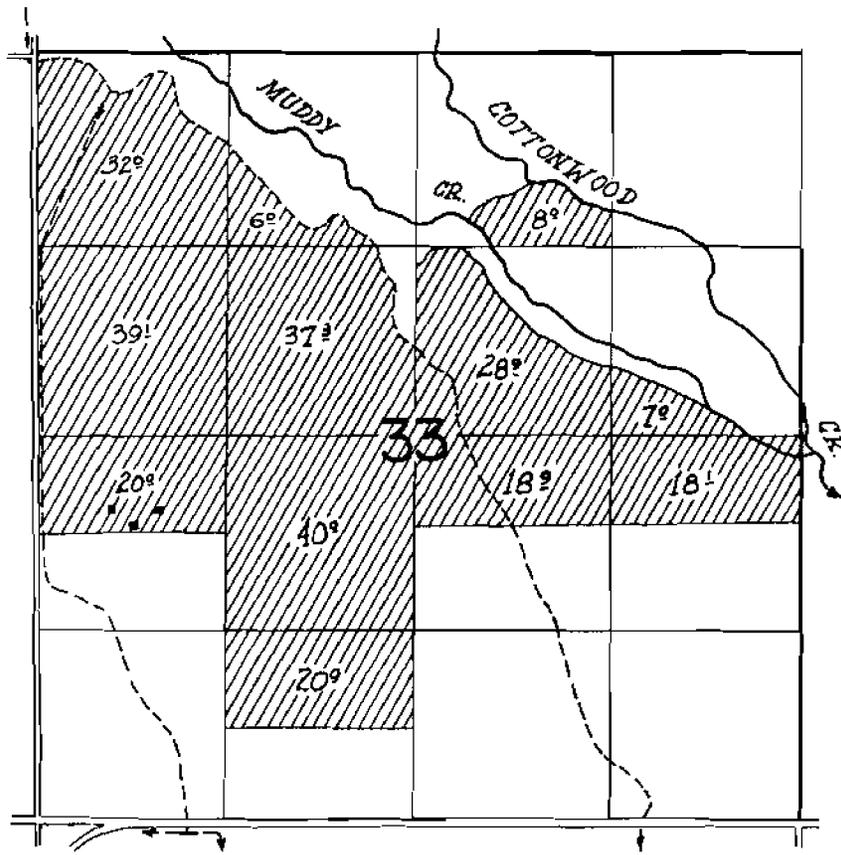


T 39 S, R 19 E, W.M.

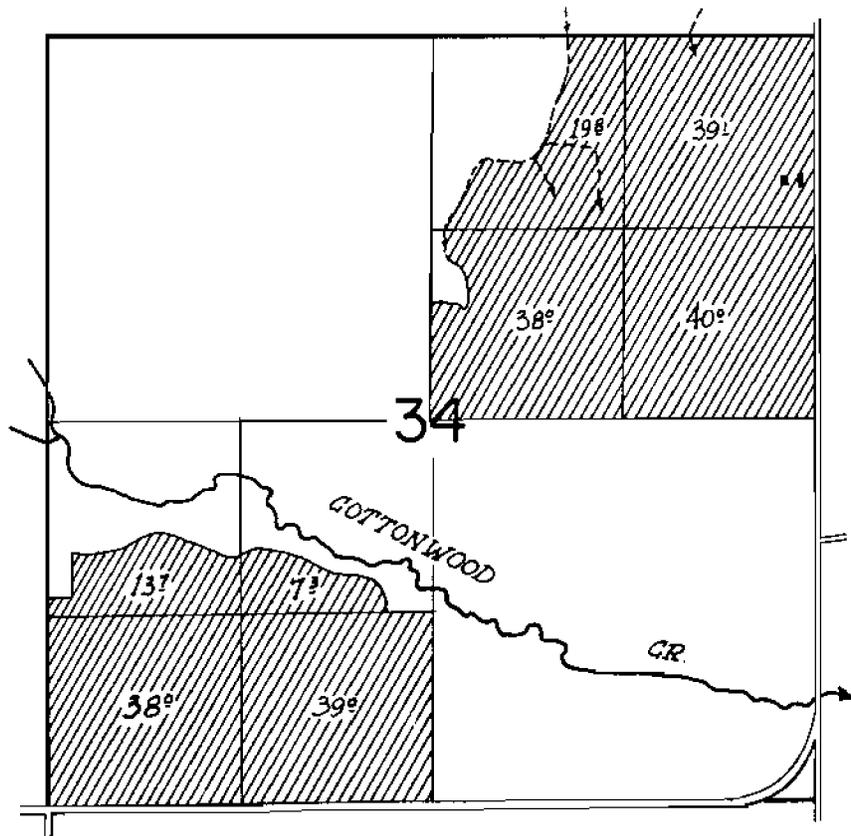


T 39 S, R 19 E, W.M.

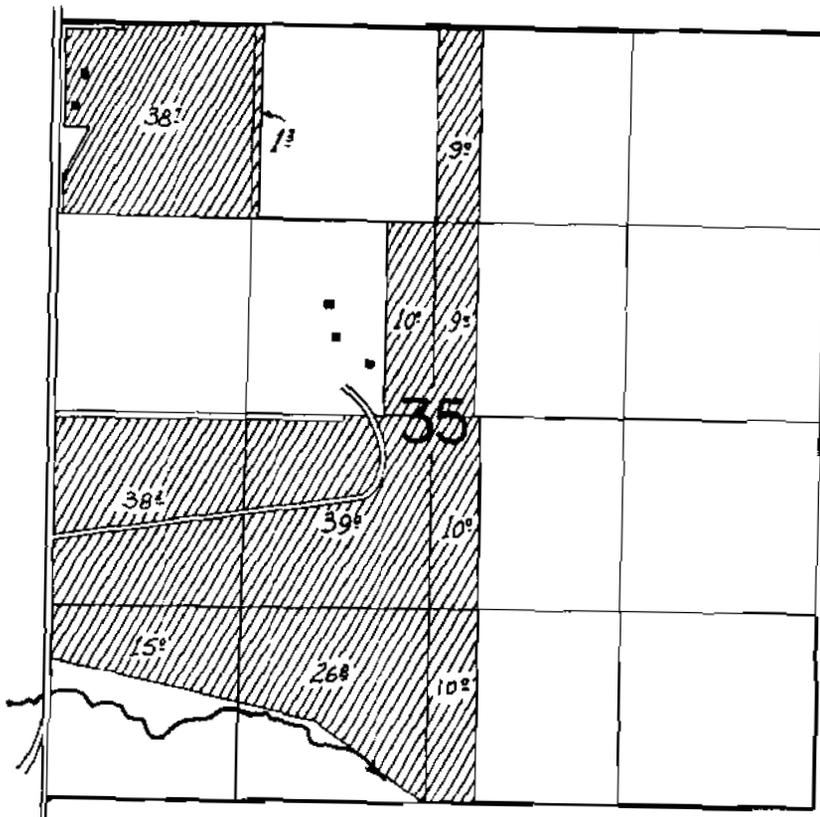


T 39 S, R 20 E, W.M.

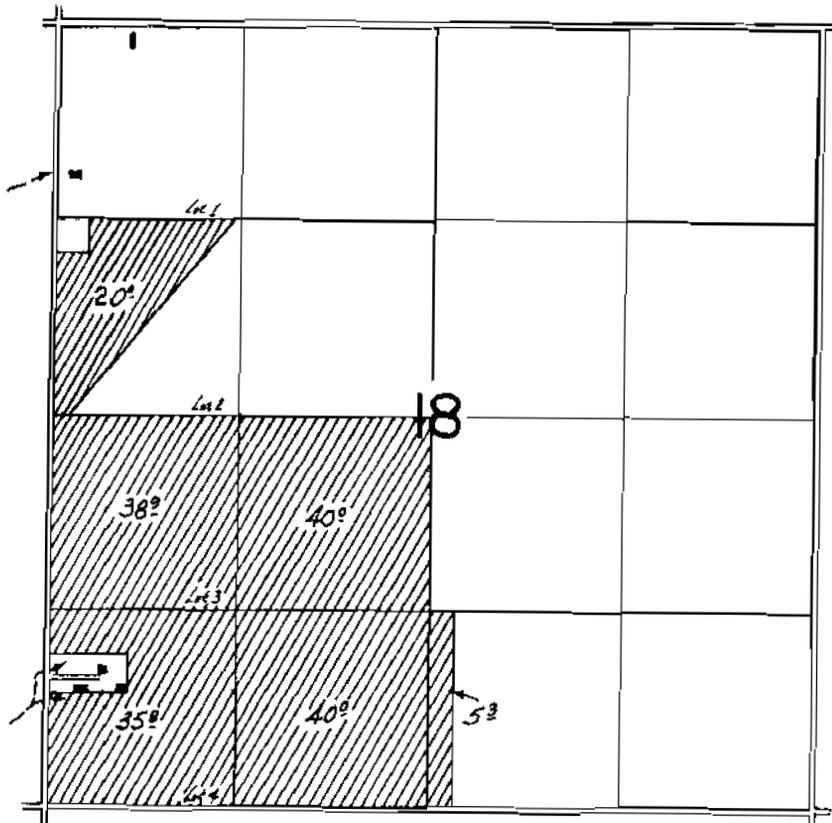


T 39 S, R 20 E, W.M.

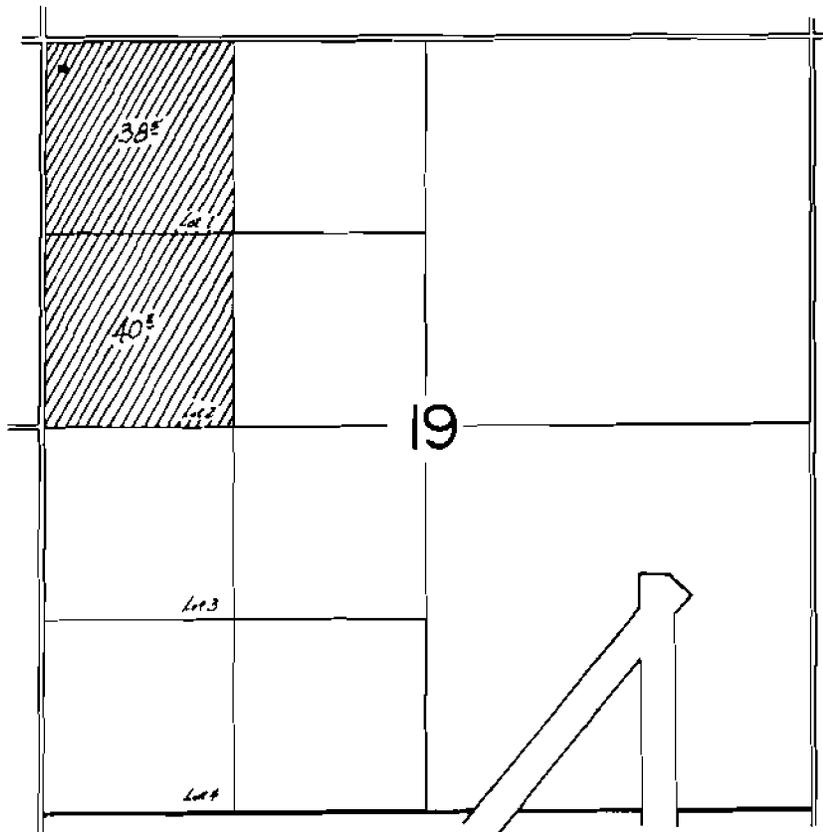


T 40 S, R 18 E, W.M.

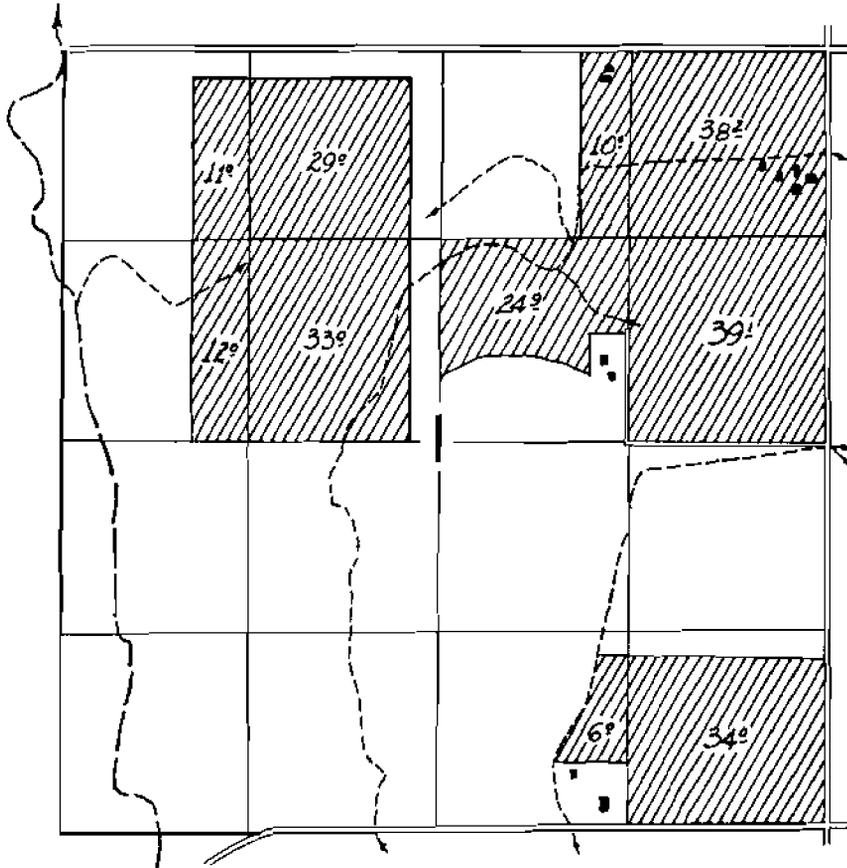


T 40 S, R 18 E, W.M.

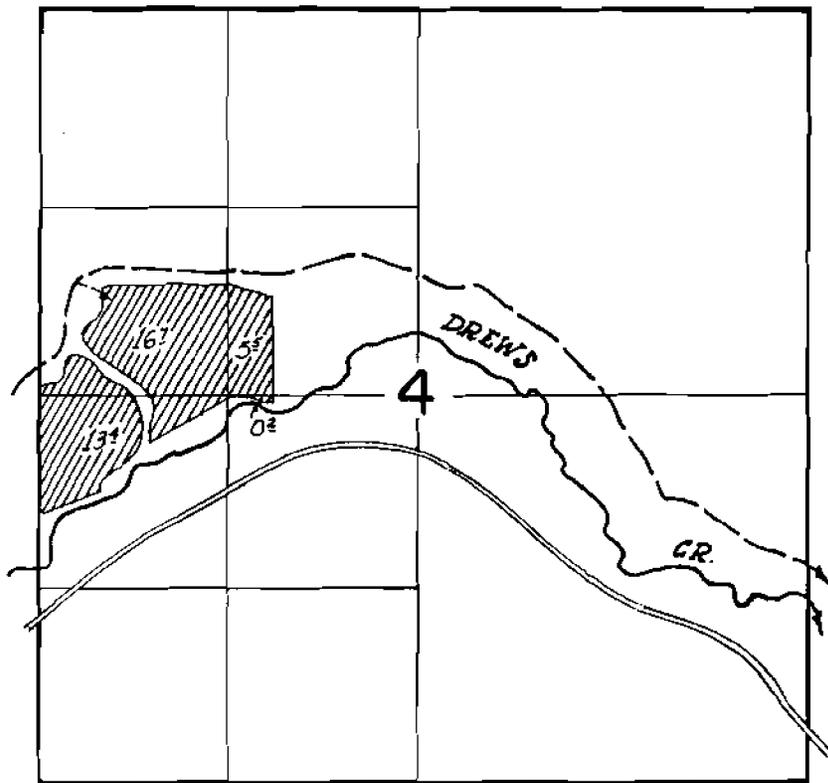


T 40 S, R 18 E, W.M.

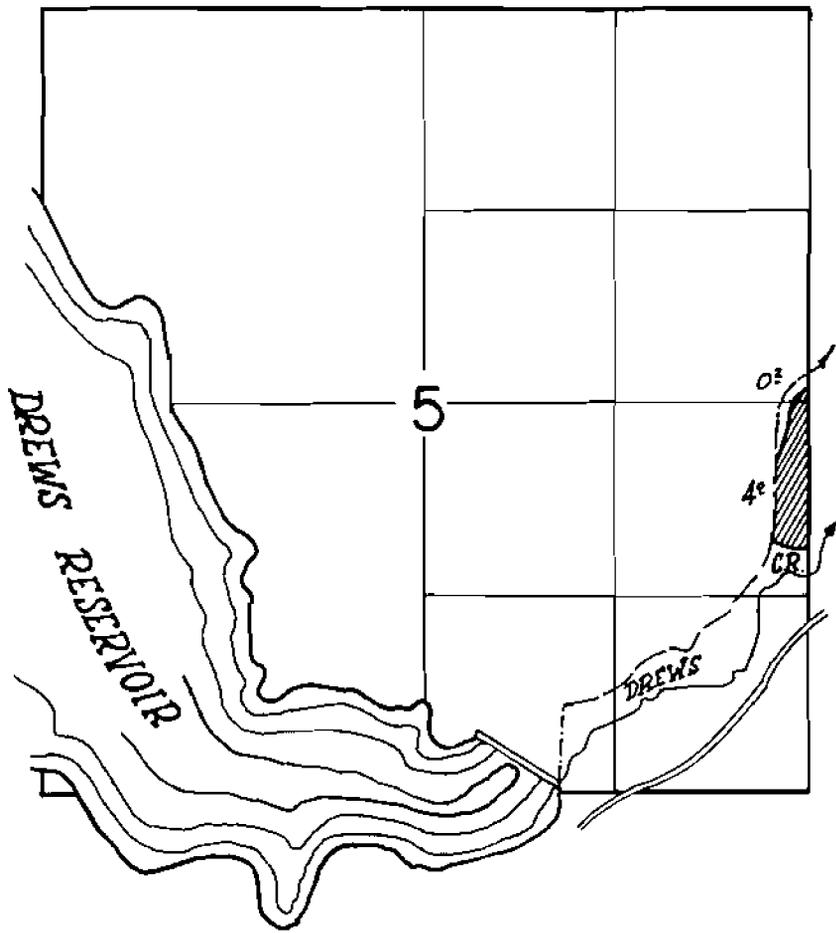


T 40 S, R 18 E, W.M.

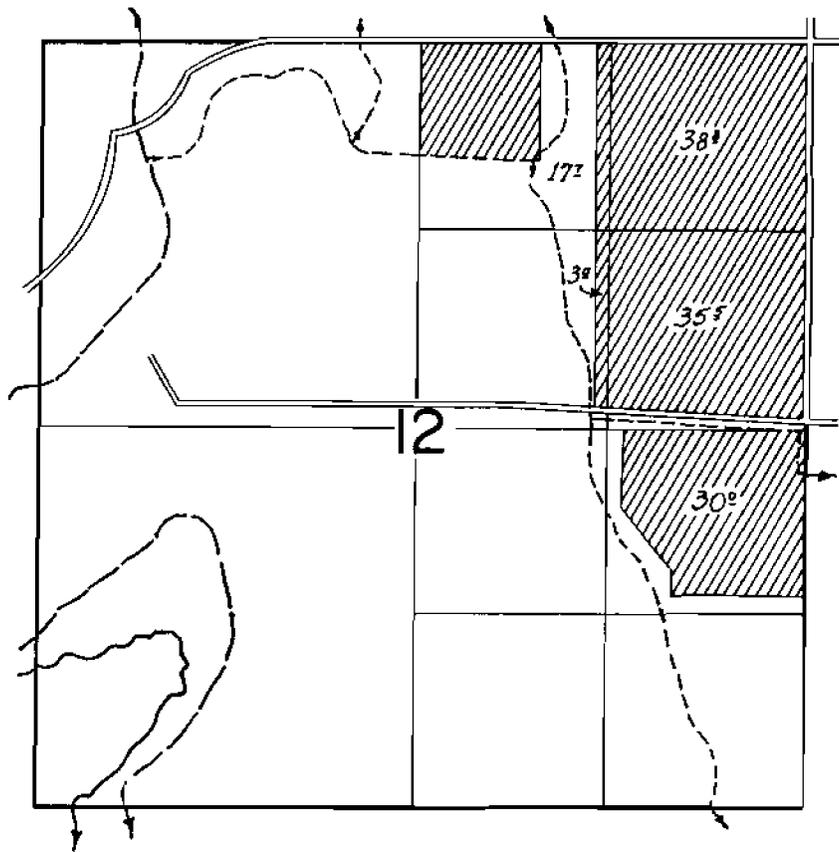


T 40 S, R 18 E, W.M.

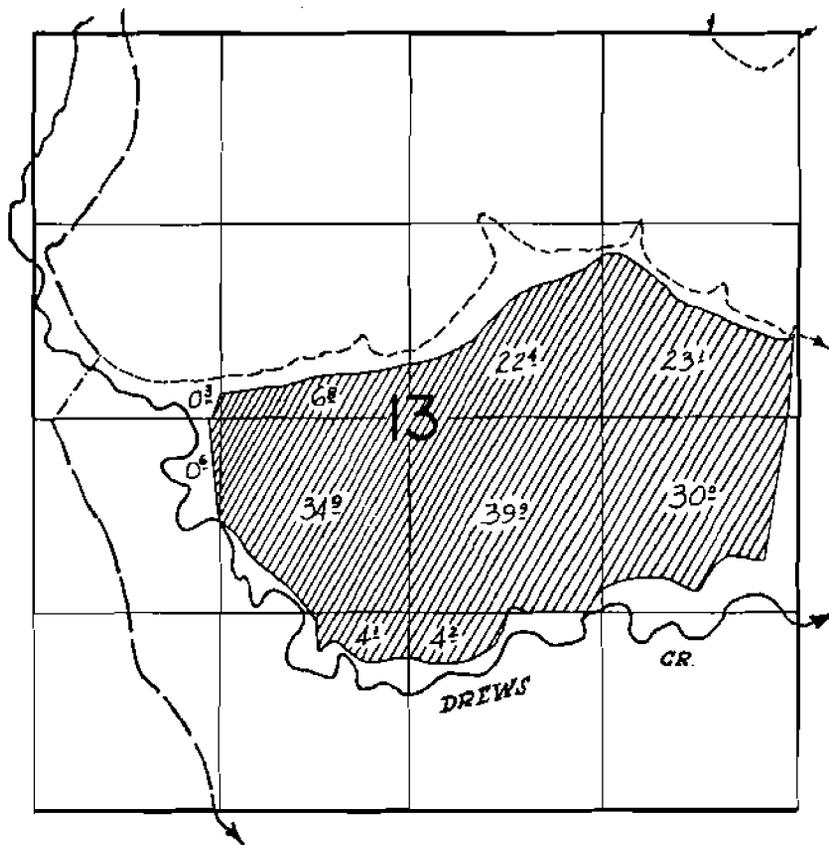


T 40 S, R 18 E, W.M.

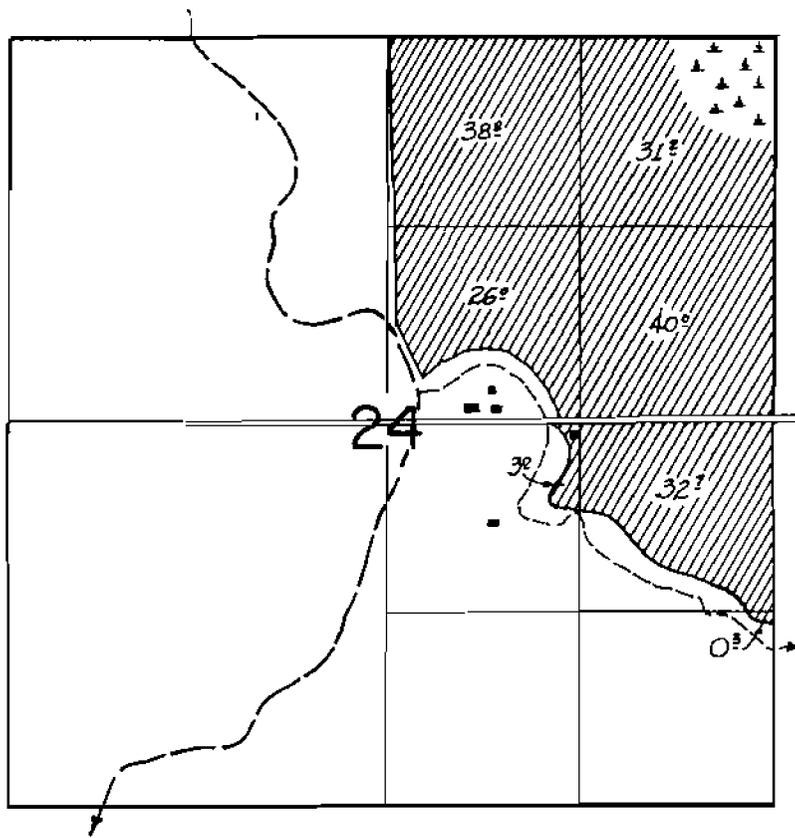


T 40 S, R 18 E, W.M.

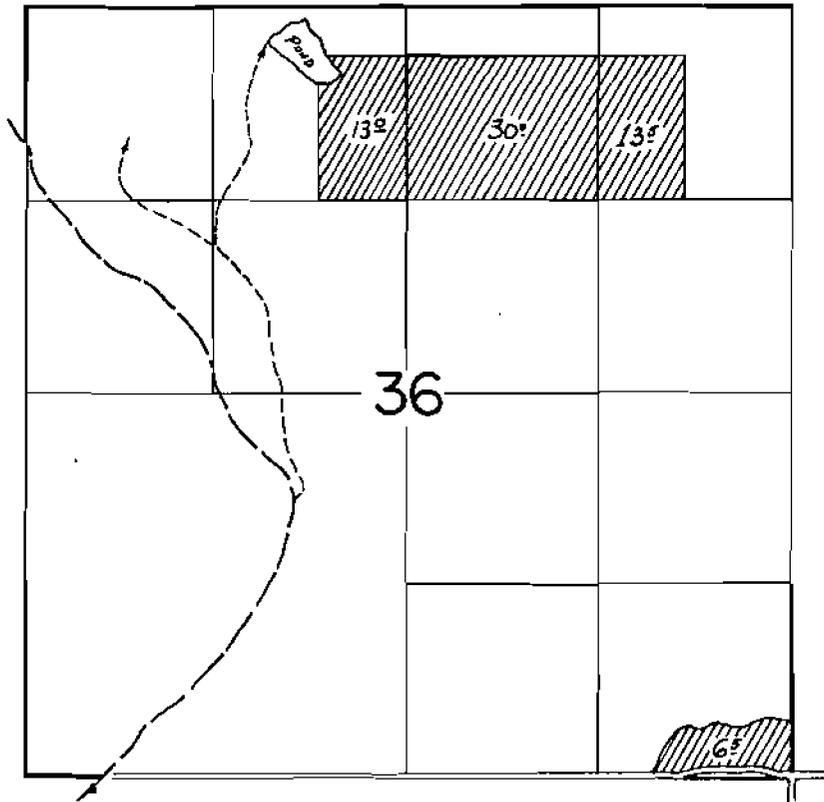


T 40 S, R 19 E, W.M.

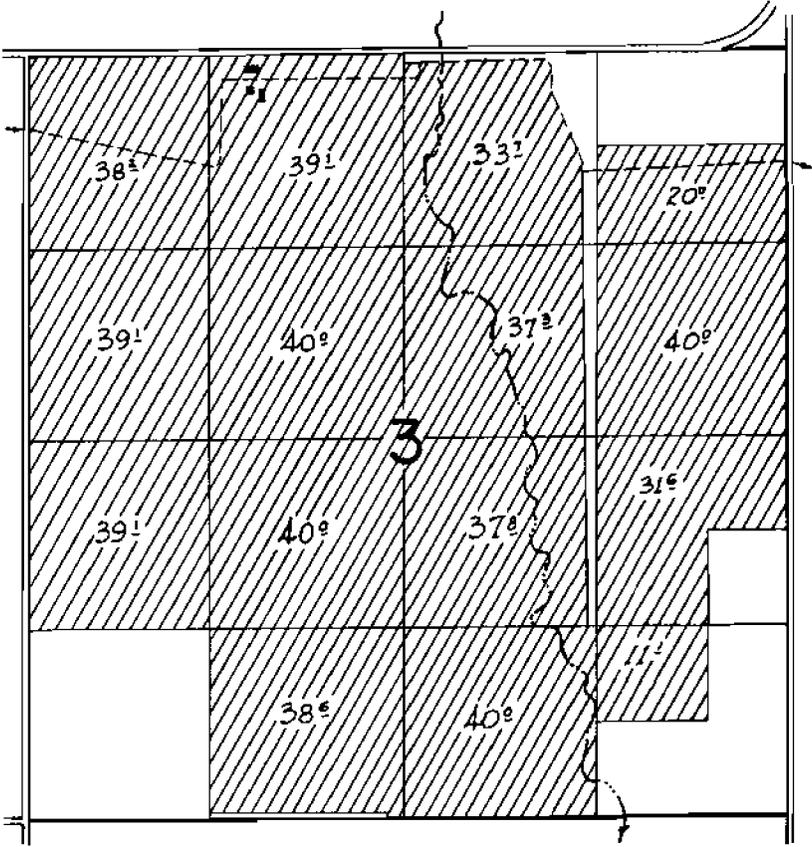


T 40 S, R 19 E, W.M.

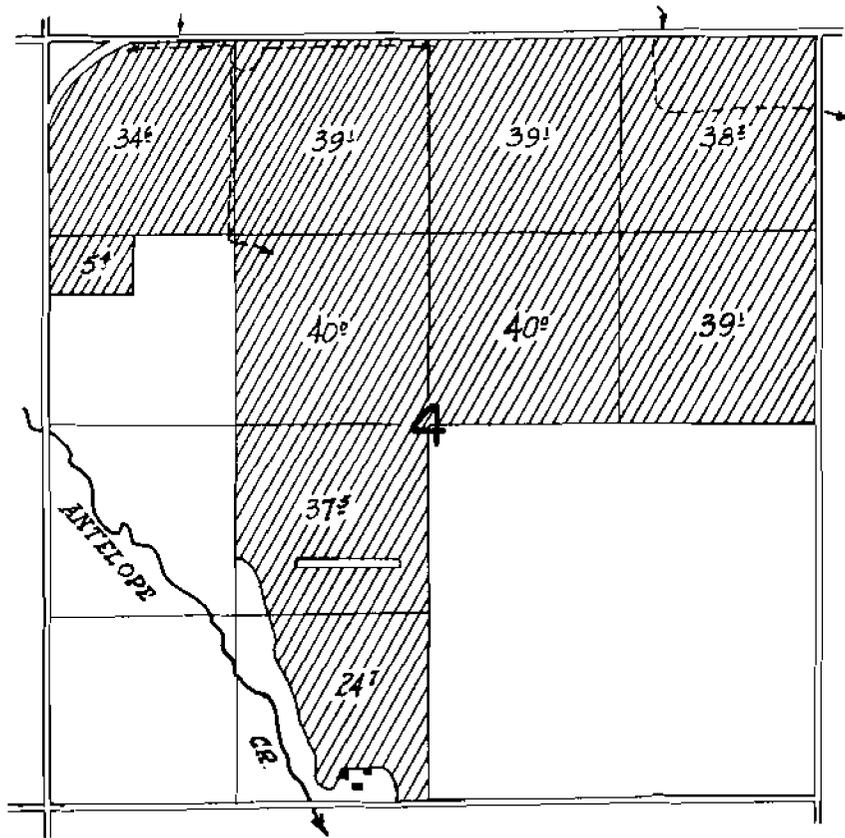


T 40 S, R 19 E, W.M.

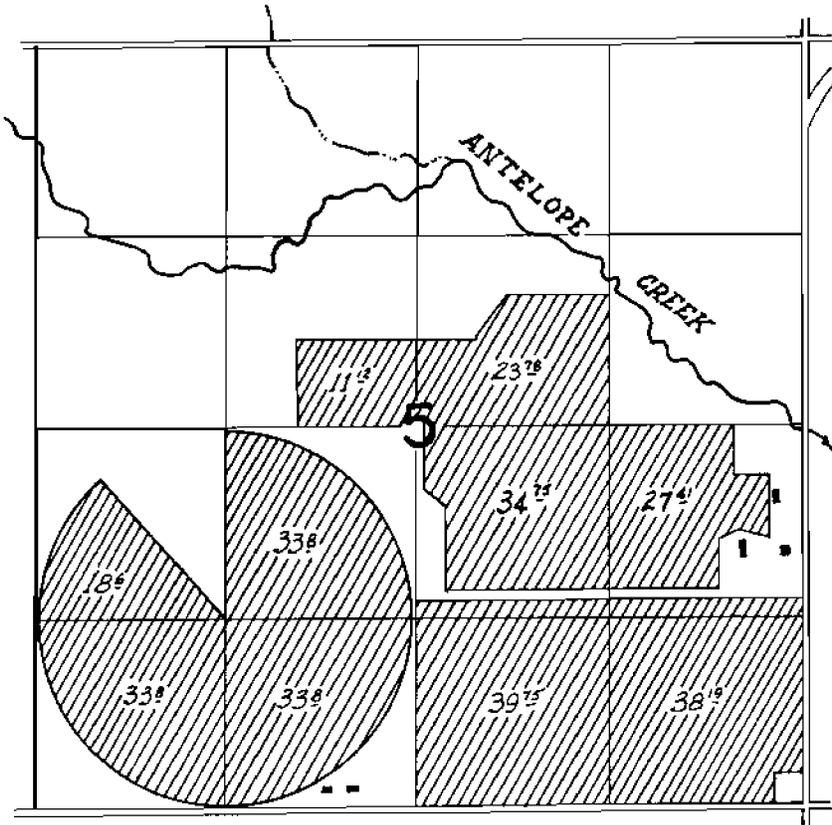


T 40 S, R 19 E, W.M.

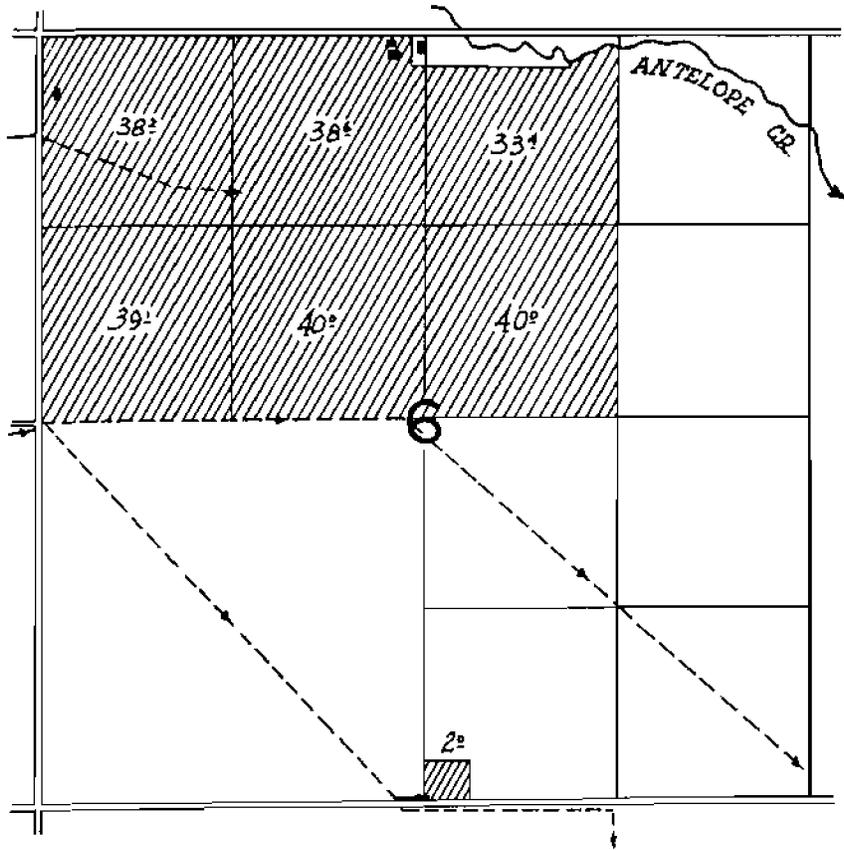


T 40 S, R 19 E, W.M.

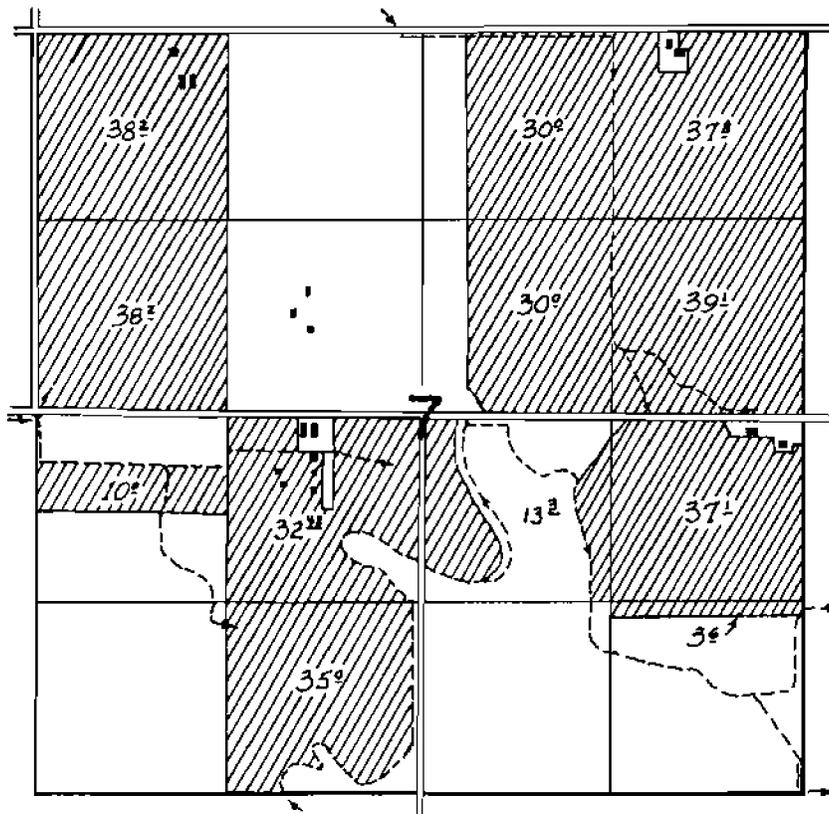


T 40 S, R 19 E, W.M.

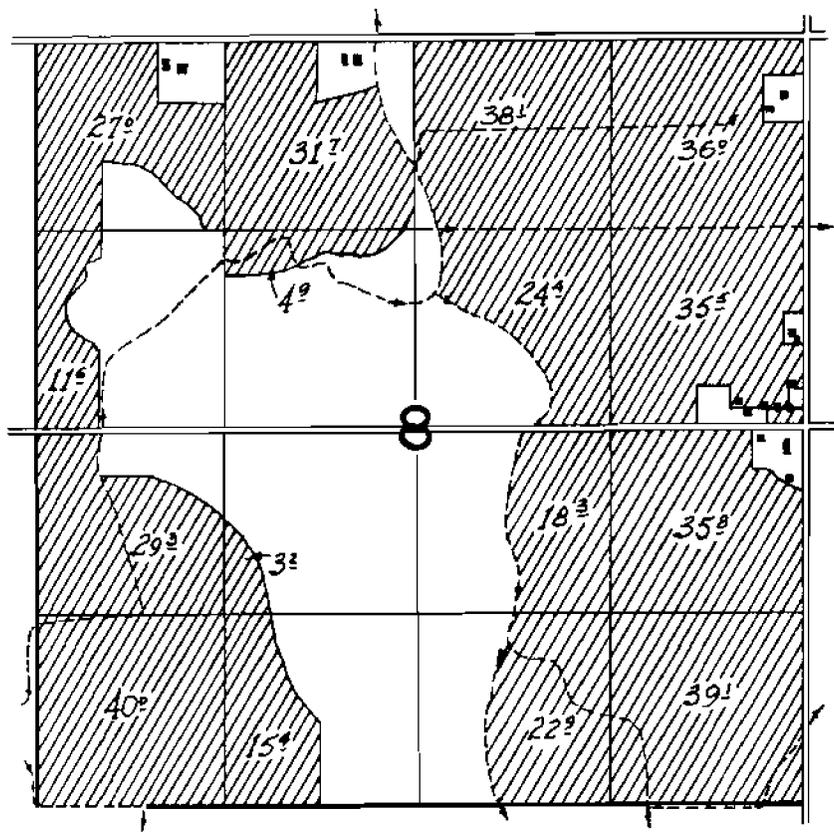


T 40 S, R 19 E, W.M.

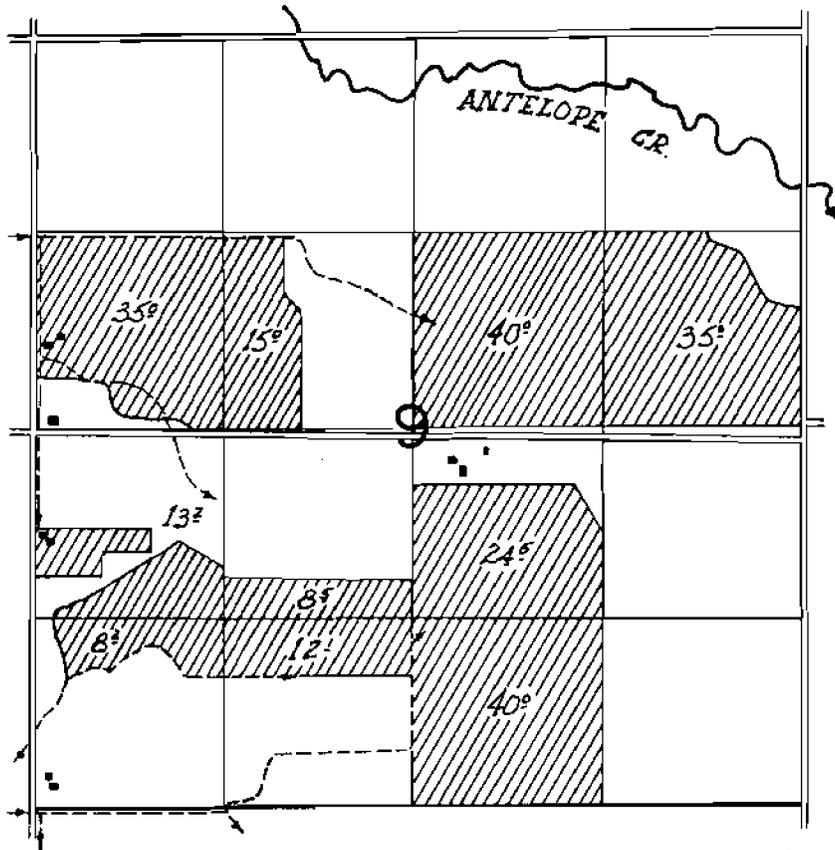


T 40 S, R 19 E, W.M.

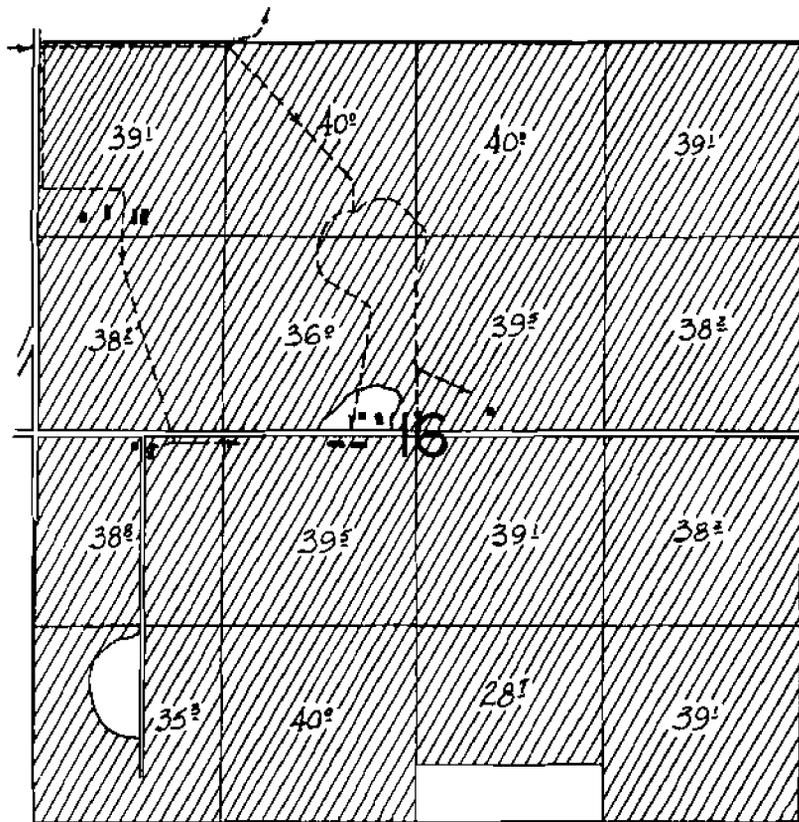


T 40 S, R 19 E, W.M.

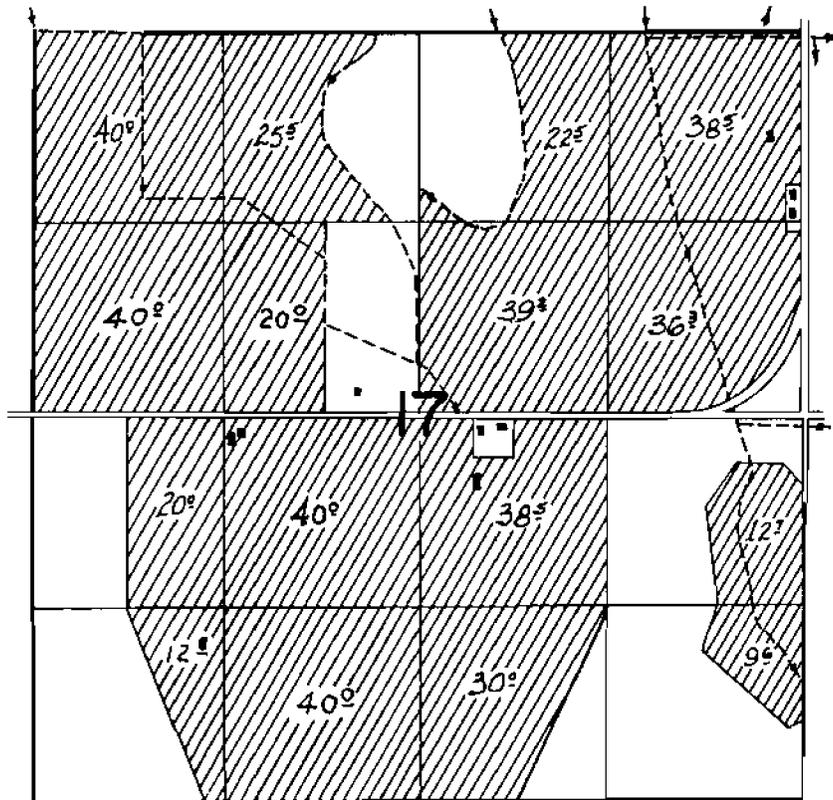


T 40 S, R 19 E, W.M.

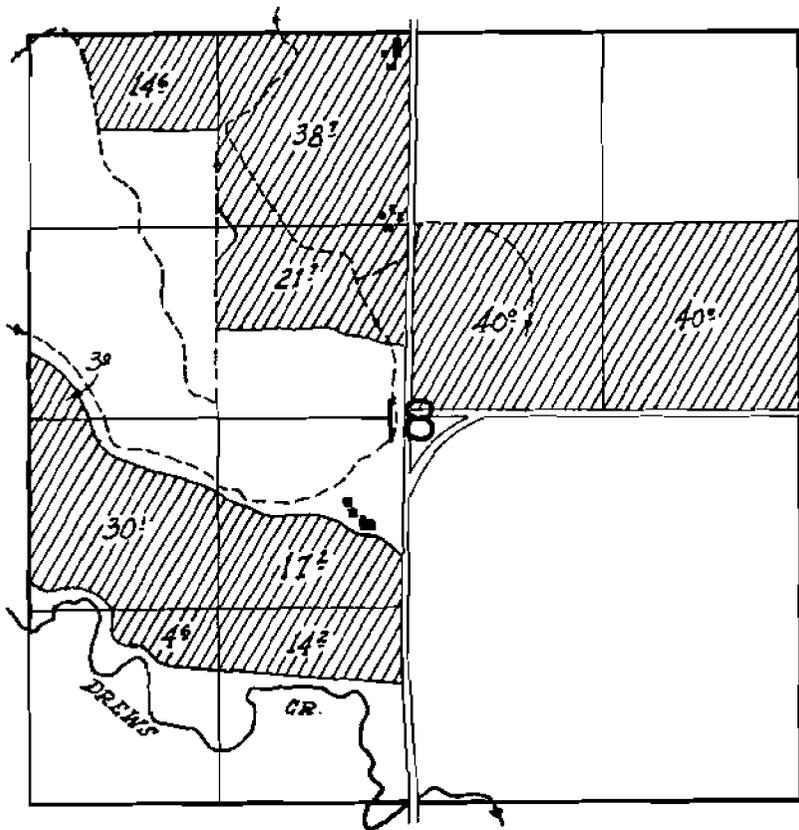


T 40 S, R 19 E, W.M.

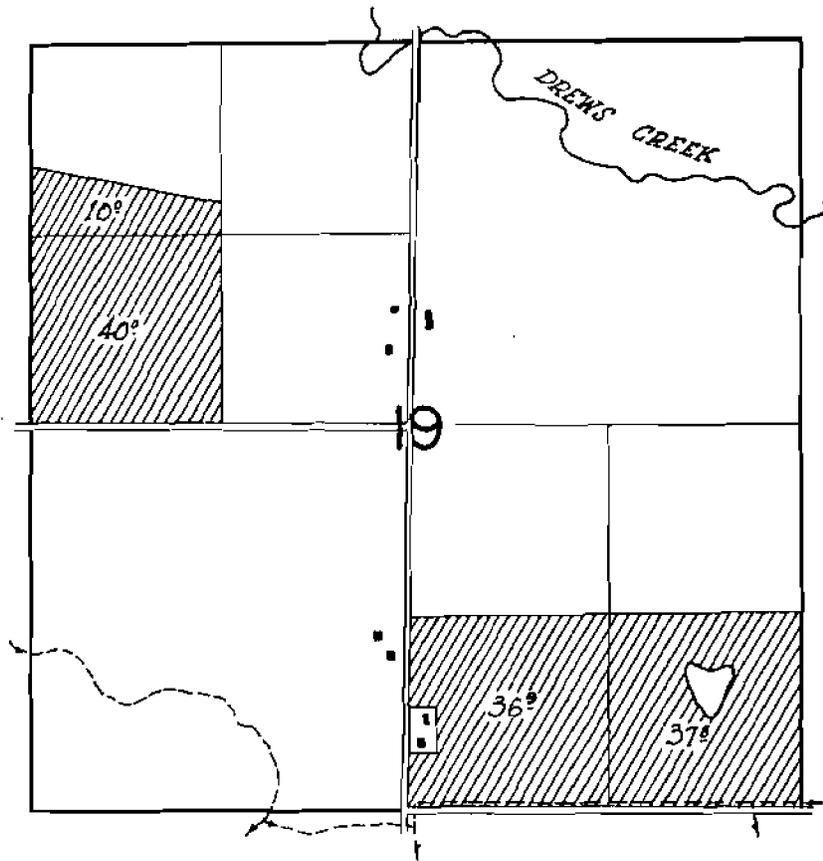


T 40 S, R 19 E, W.M.

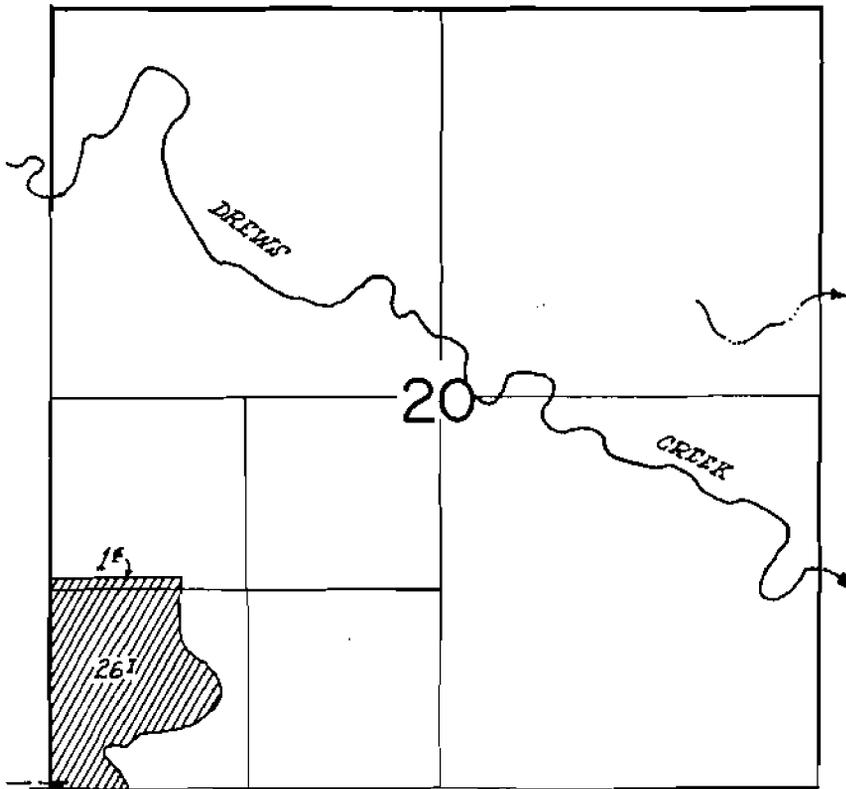


T 40 S, R 19 E, W.M.

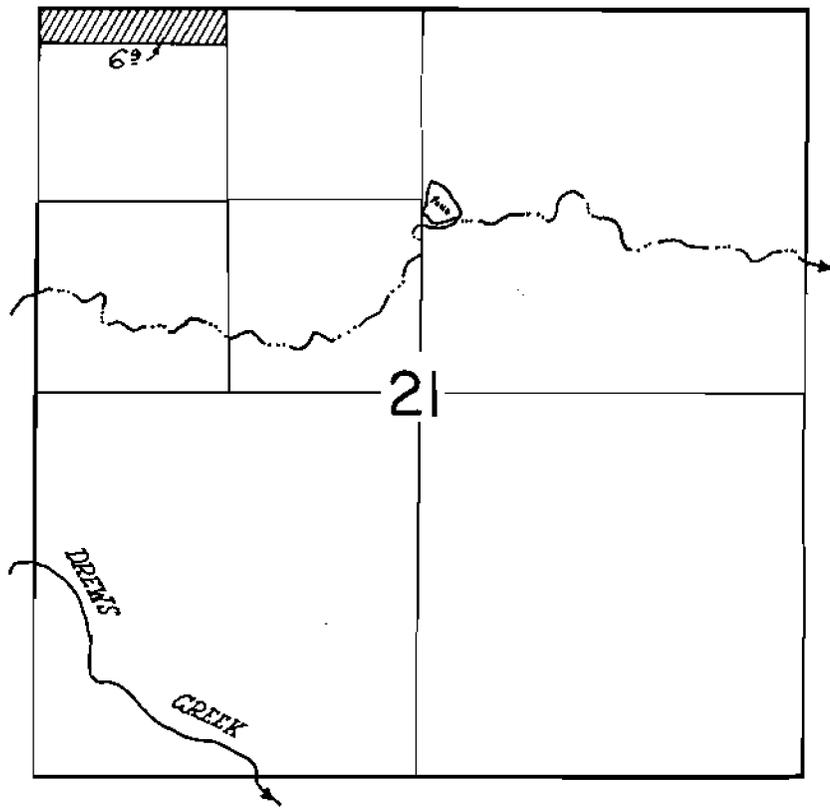


T 40 S, R 19 E, W.M.

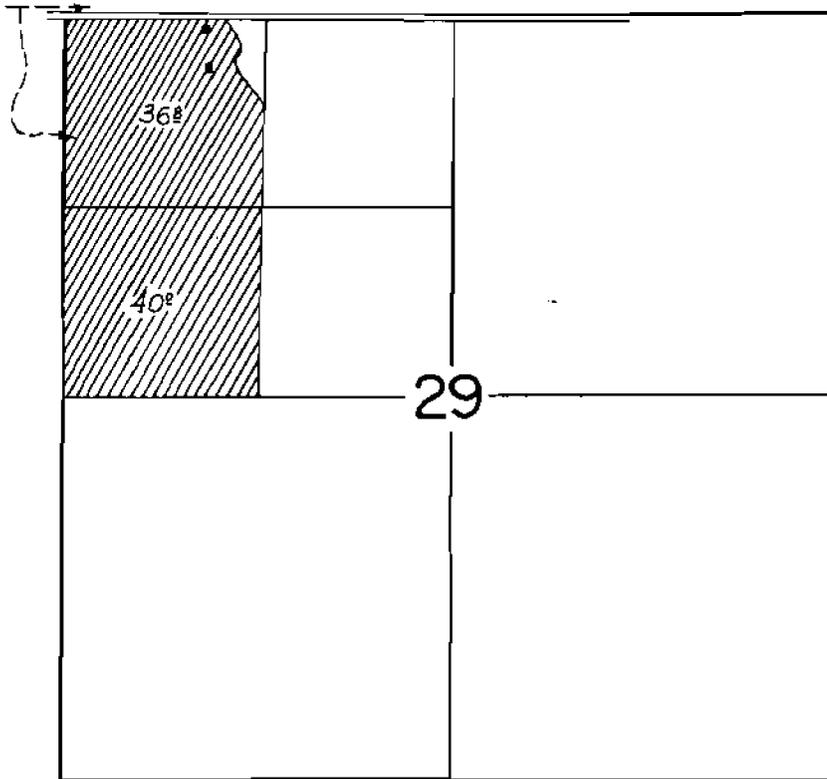


T 40 S, R 19 E, W.M.

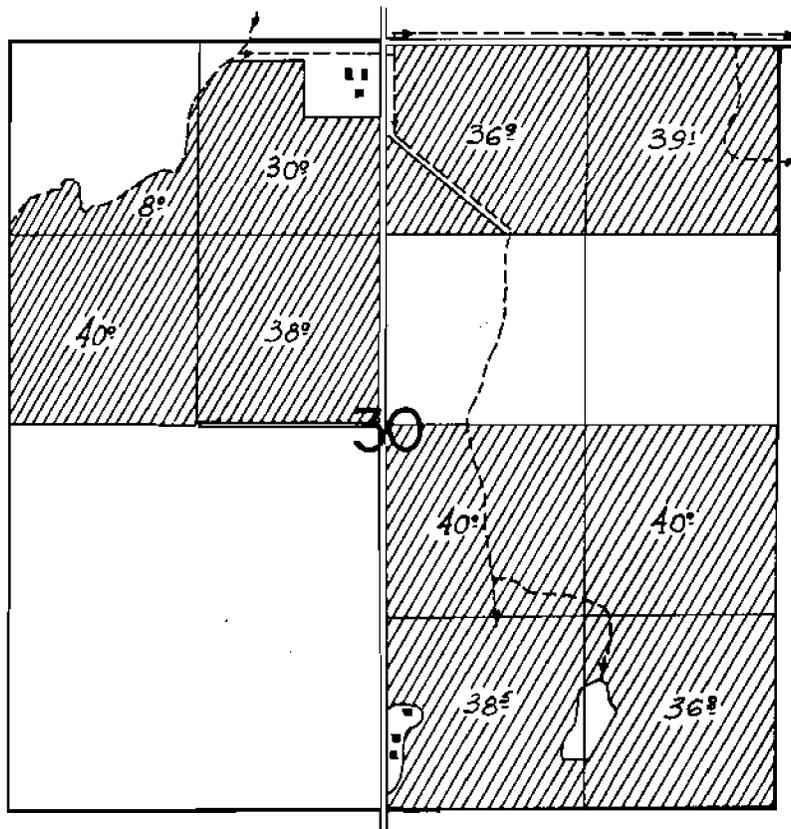


T 40 S, R 19 E, W.M.

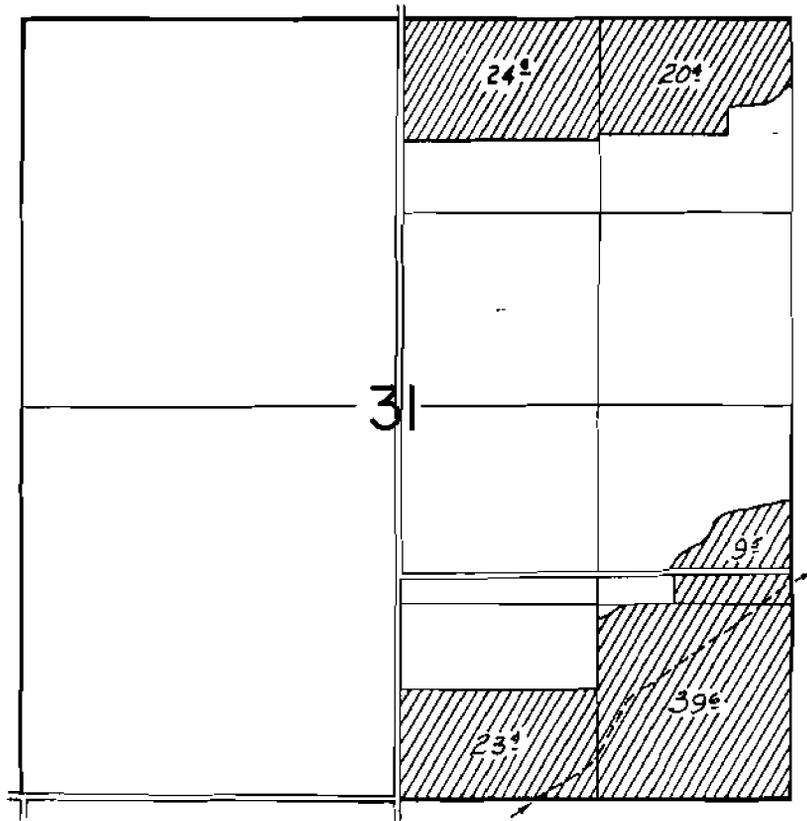


T 40 S, R 19 E, W.M.

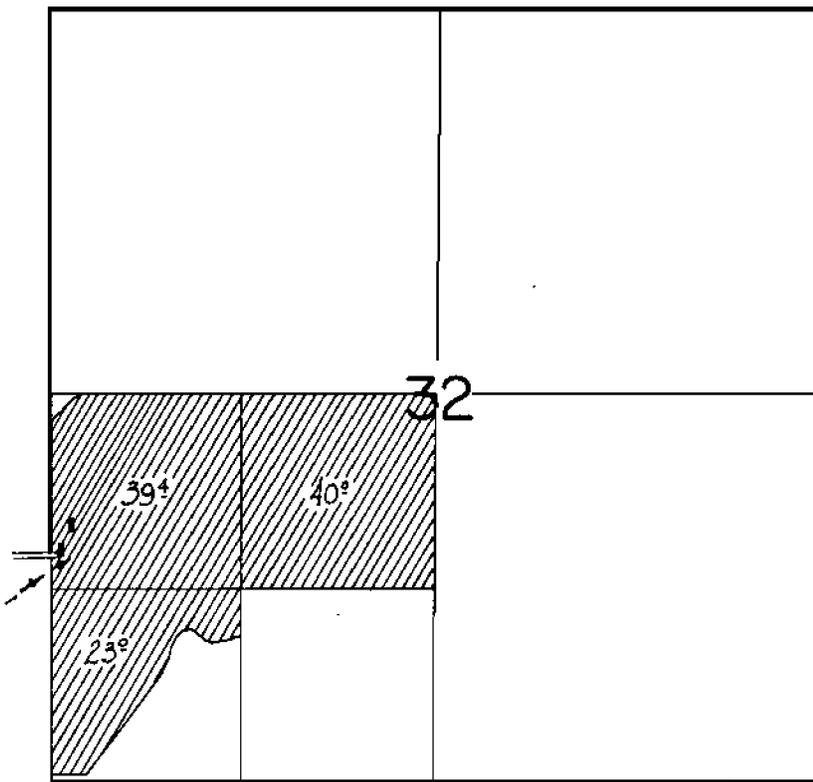


T 41 S, R 18 E, W.M.

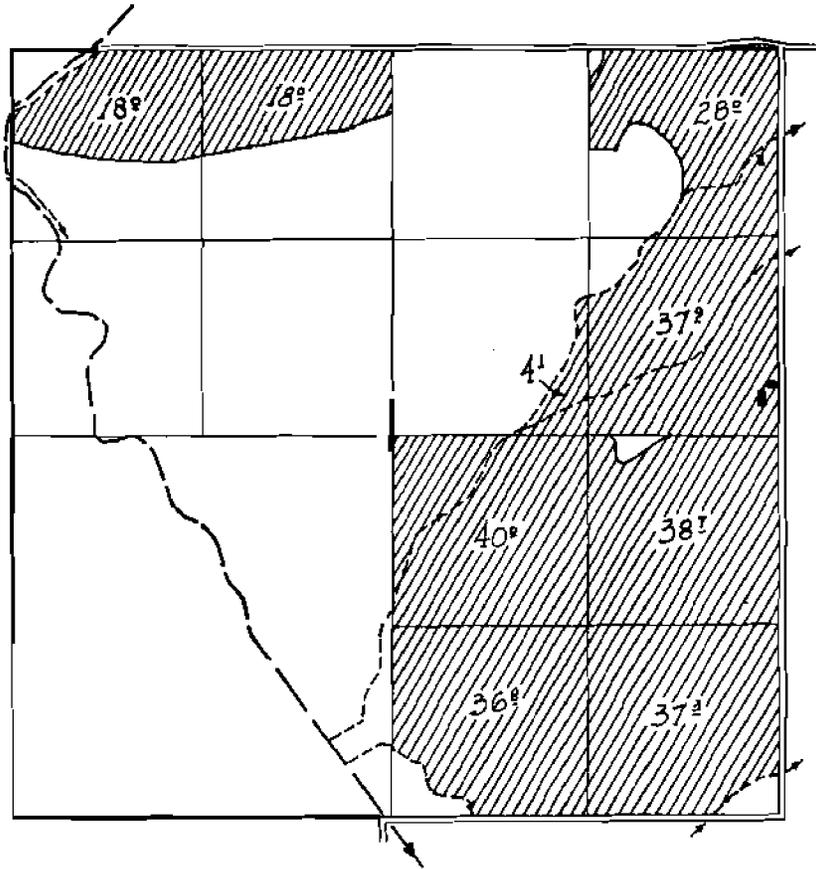


T 41 S, R 18 E, W.M.

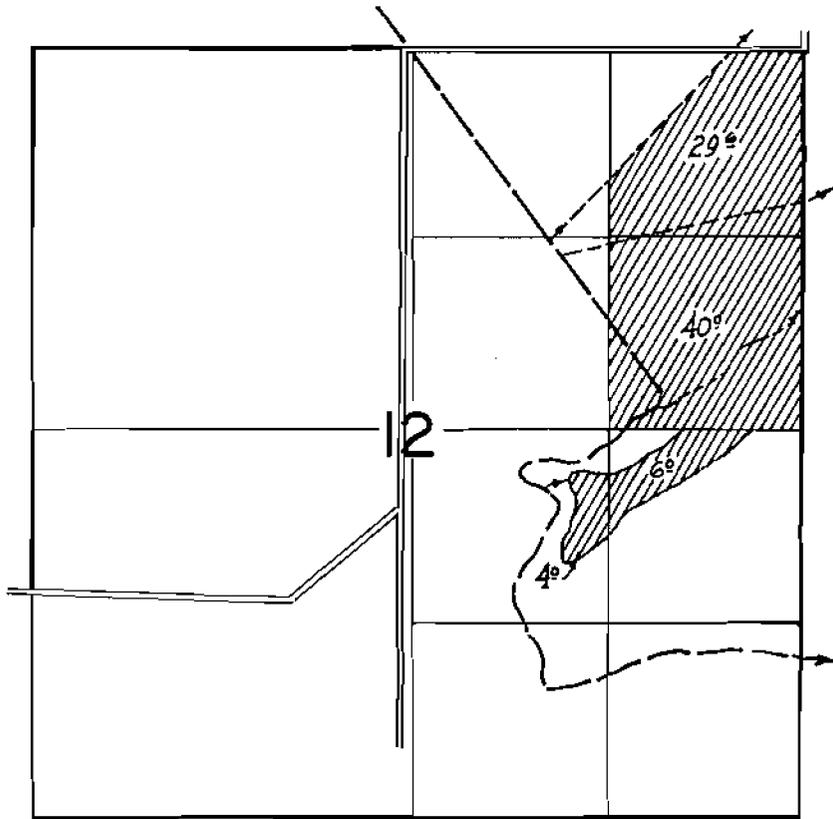


T 41 S, R 19 E, W.M.

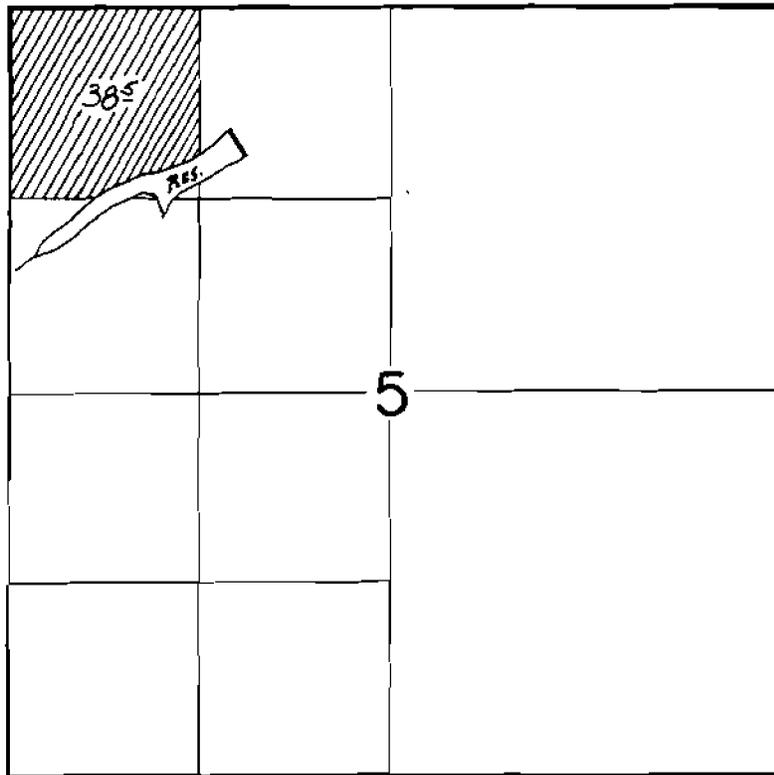


T 41 S, R 19 E, W.M.

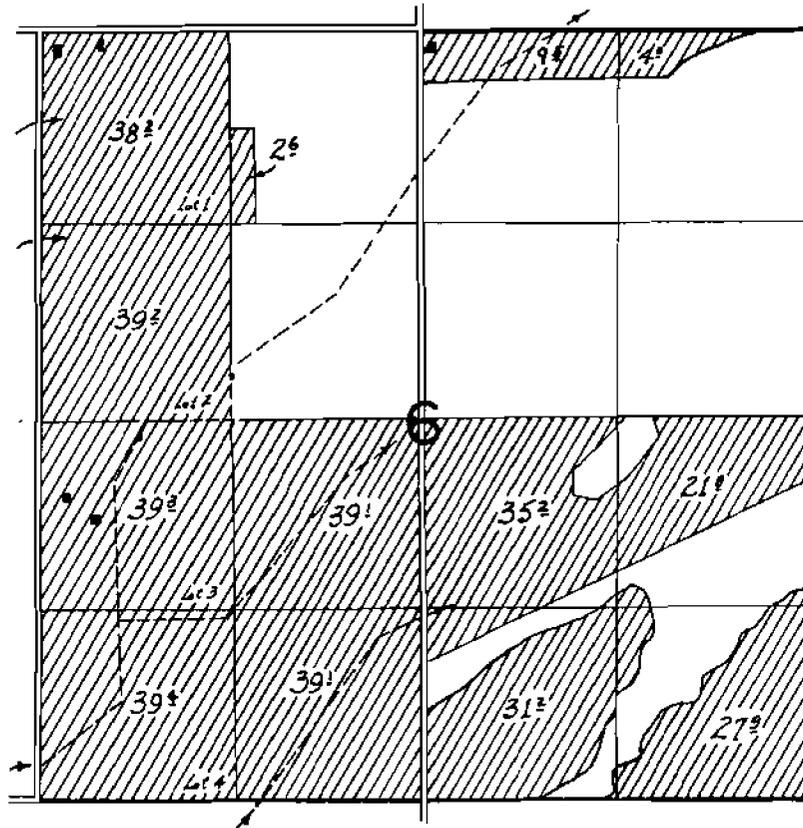


T 41 S, R 19 E, W.M.

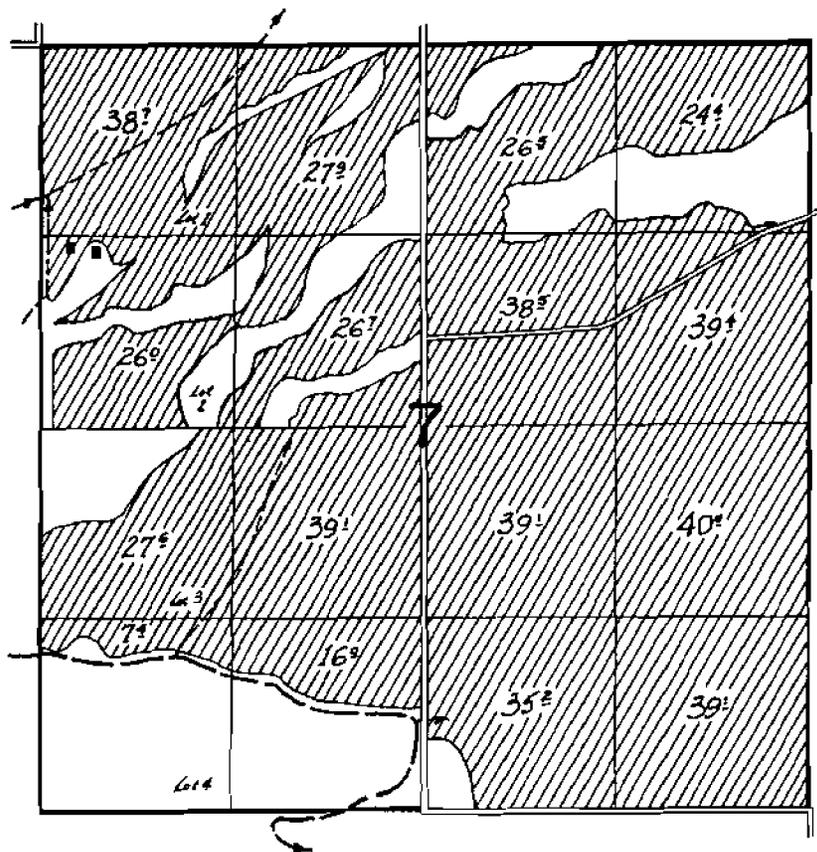


T 41 S, R 19 E, W.M.

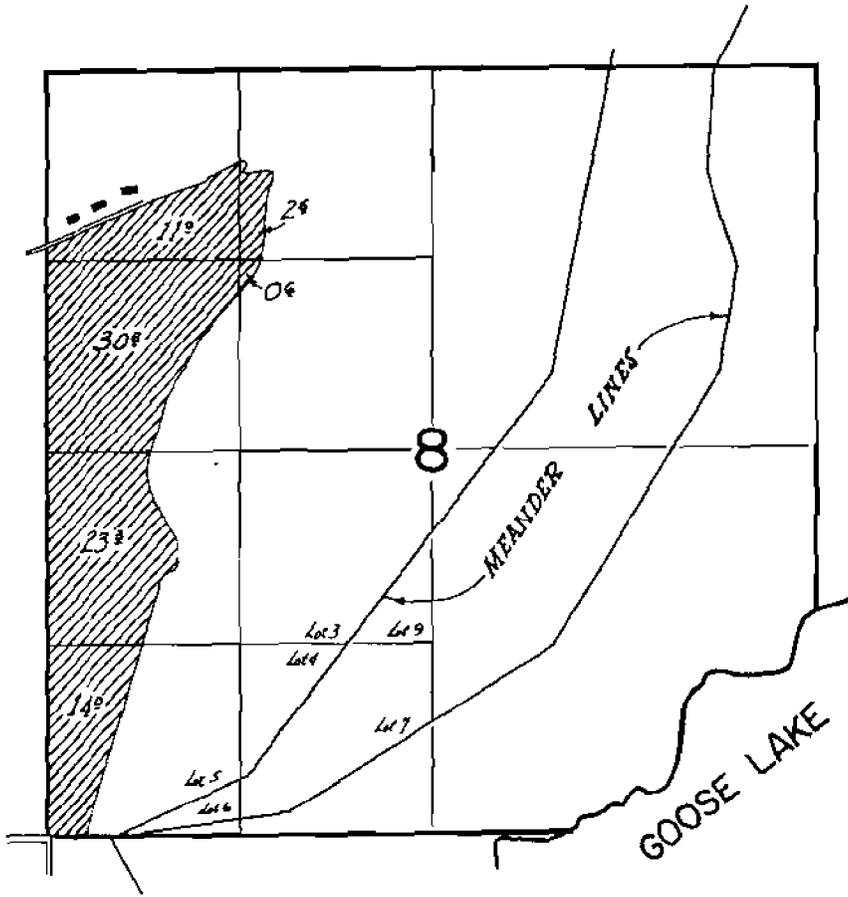

T 41 S, R 19 E, W.M.

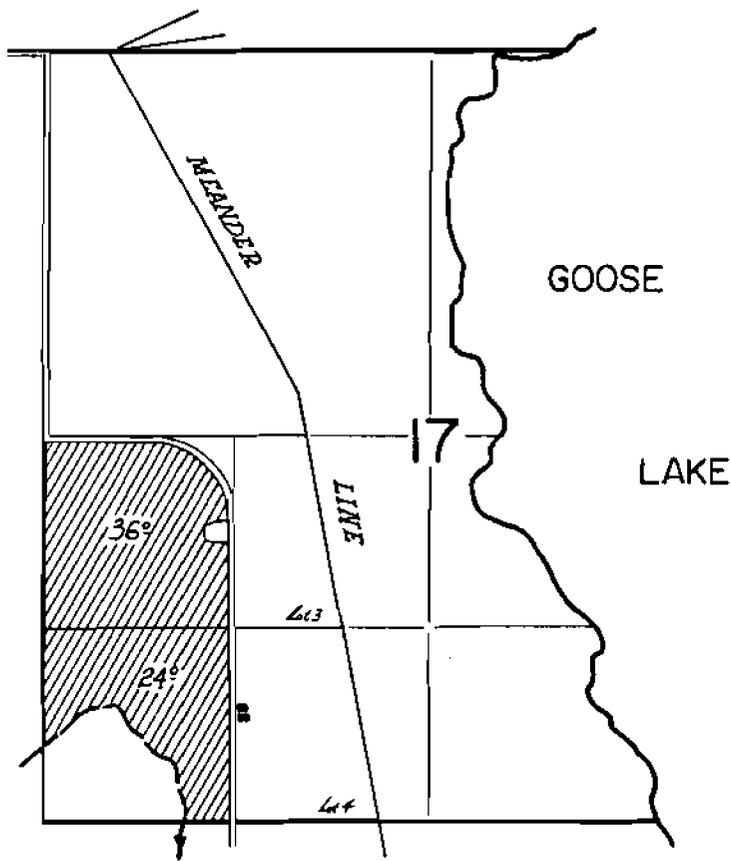

T 41 S, R 19 E, W.M.

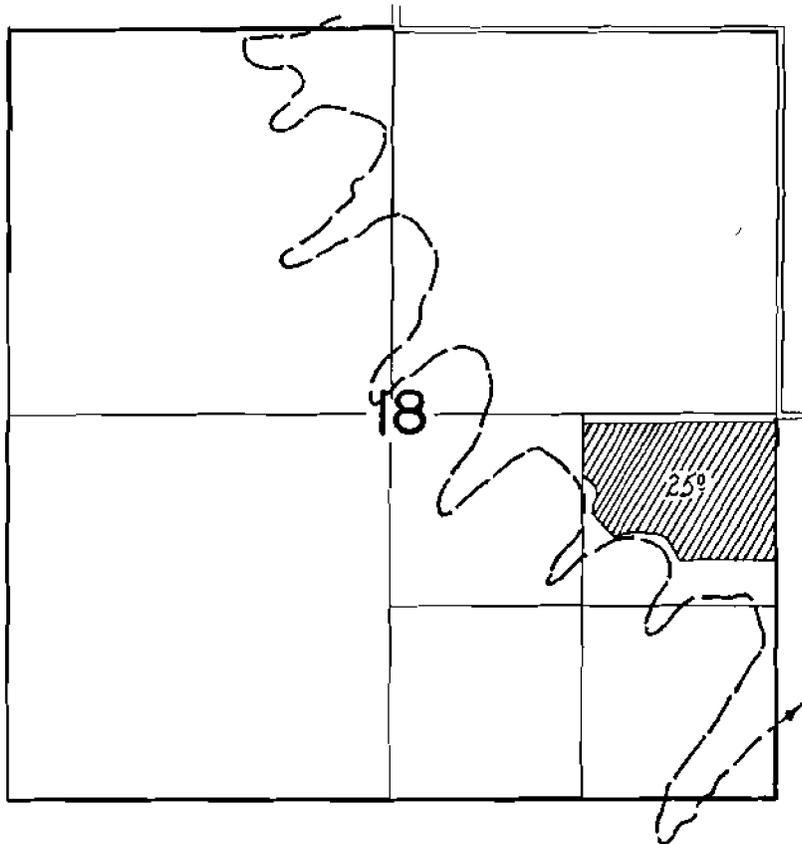

T 41 S, R 19 E, W.M.

