


T.14S. R.8W. W.M.

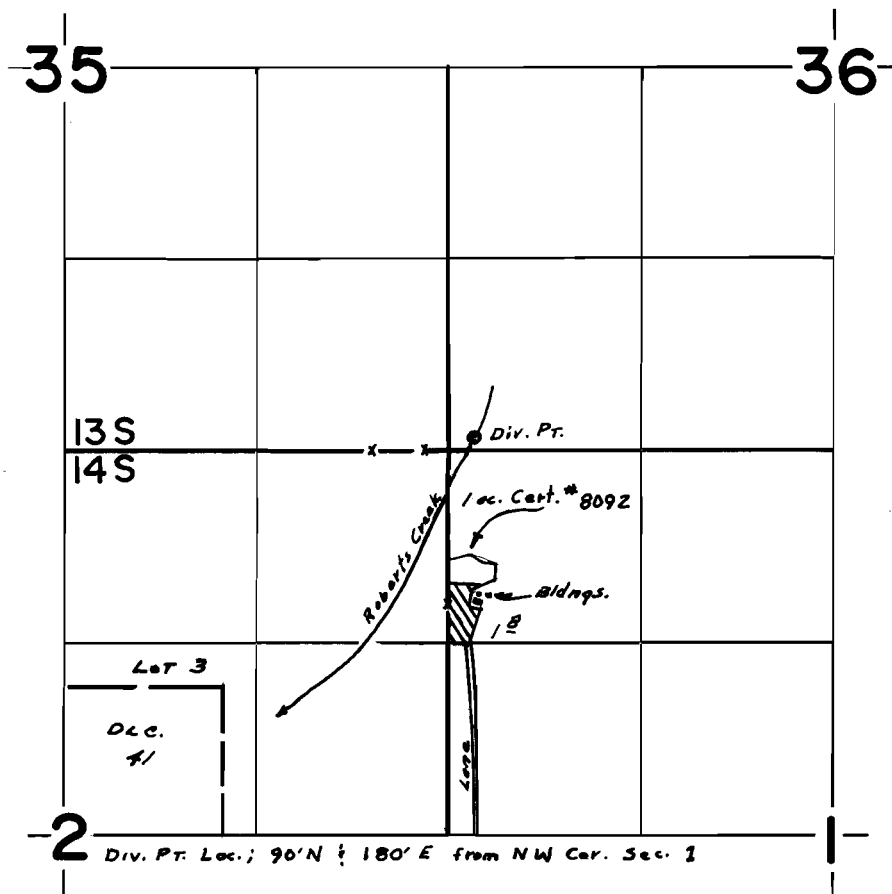

FINAL PROOF SURVEY
UNDER

Application No. 43587 Permit No. 32592
IN NAME OF

EVERETT CRUMP

Surveyed 9-23 1977, by ROBERT BARWIN