


T.2 S. R.3 E. W.M.

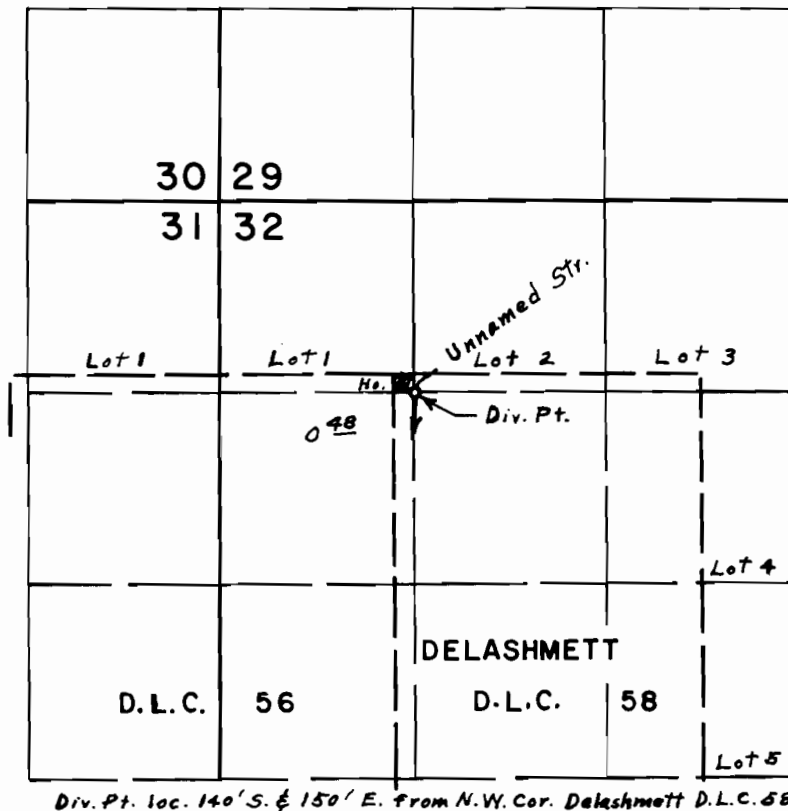

FINAL PROOF SURVEY
UNDER

Application No. 42485 Permit No. 31771
IN NAME OF

GORDON G. HOHMAN

Surveyed Sept. 10, 1976, by L. E. Gould