


T. 2S. R. 4E. W.M.

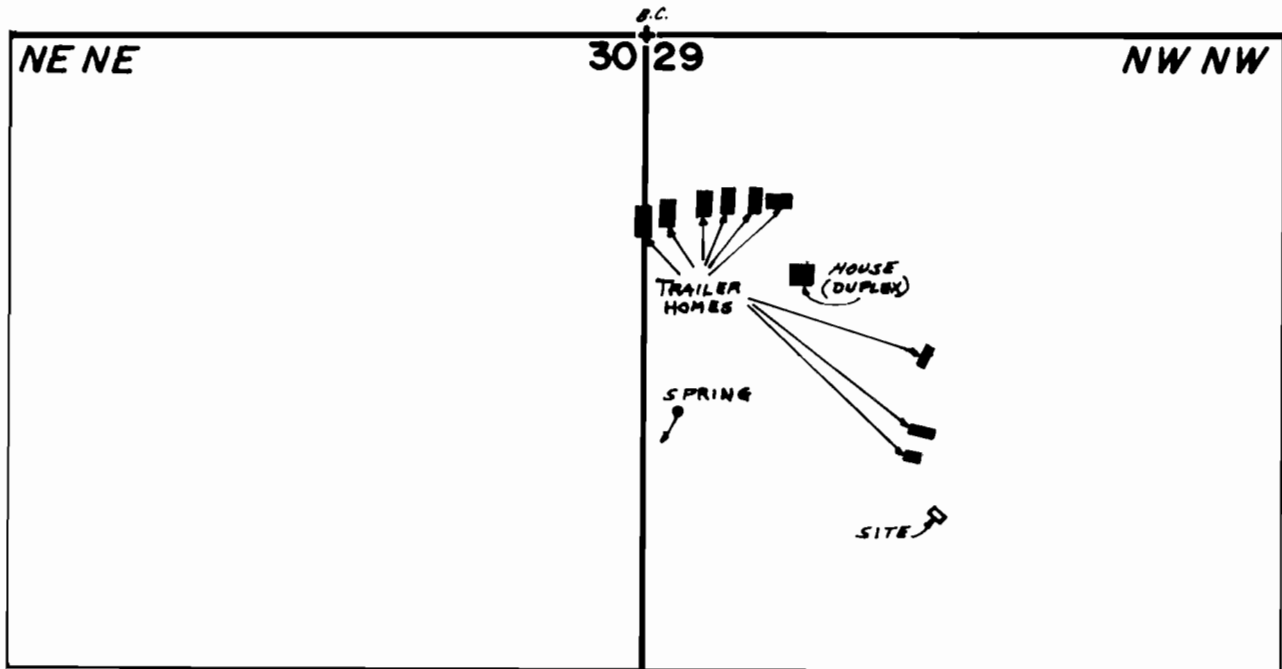

SPRING LOC. - 780' S & 70' E FROM NW COR. SEC. 29

Scale - 1" = 400'

FINAL PROOF SURVEY
UNDER

Application No. 47324 Permit No. 35452..
IN NAME OF

.....BEULAH I. NORTH.....

Surveyed MAY 2, 1978, by J.S. Donaldson..