


T.2S.R.4E.W.M.

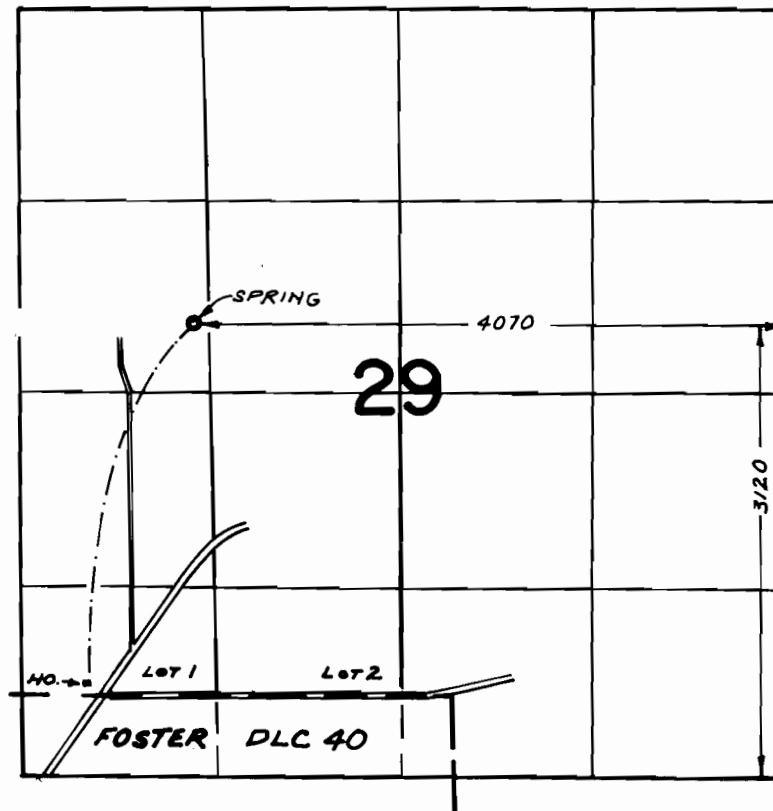

**FINAL PROOF SURVEY**  
UNDER

Application No. 54033 Permit No. 40479  
IN NAME OF

STEVEN E. & BARBARA E. HICKS

Surveyed AUG. 15 1977, by R. MUCKEN