


# T.2S.R.1E.W.M.

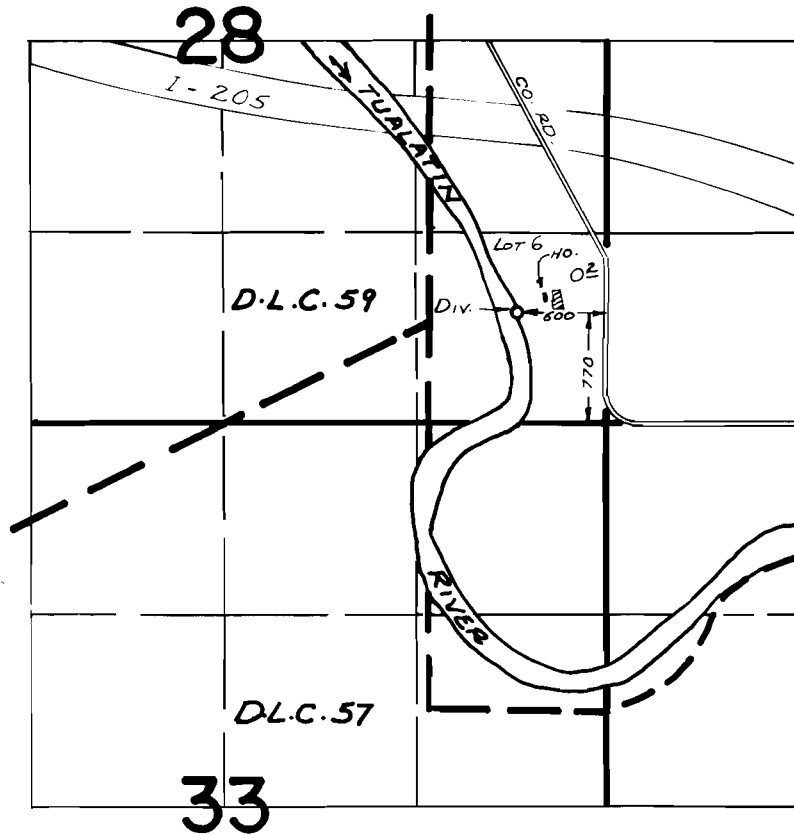

## FINAL PROOF SURVEY UNDER

Application No. 54084 Permit No. 40492  
IN NAME OF

ROBERT R. & HELEN L. EASTMAN

Surveyed JULY 6, 1977, by R. MUCKEN