


T.5N. R.2W. W.M.

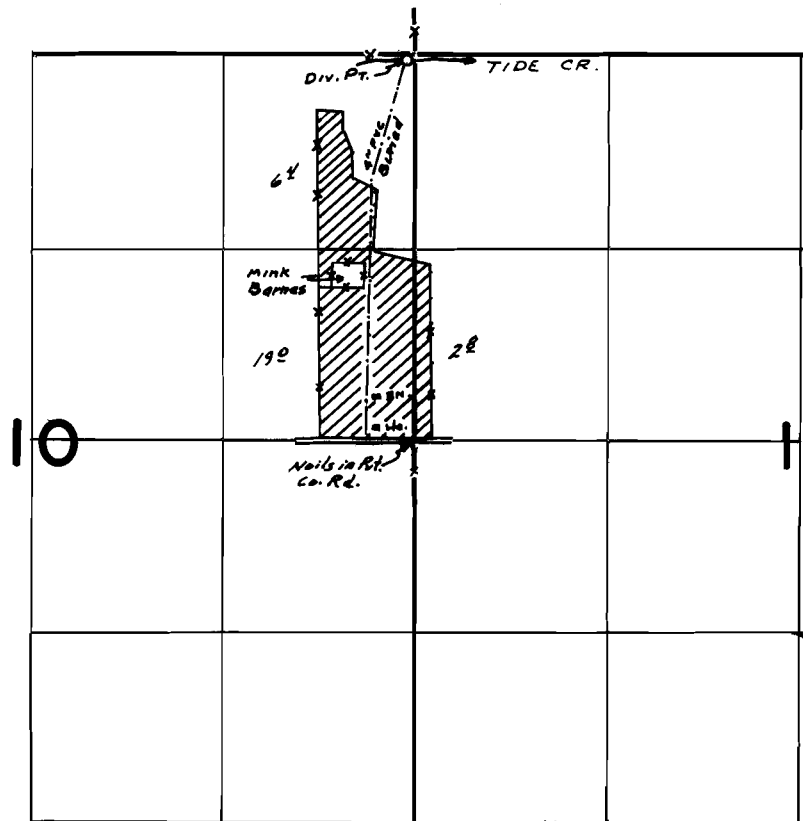

Div. Pt. Loc. - 50' S & 50' W from NE Cor. Sec. 10

FINAL PROOF SURVEY
UNDER

Application No. 50205. Permit No. 37311.....
IN NAME OF

JAMES D. & DONNA OBERMAIER TAYLOR

Surveyed 8-12..... 1977, by S.C. BROWN.....