


T.16&17S. R.20E. W.M.

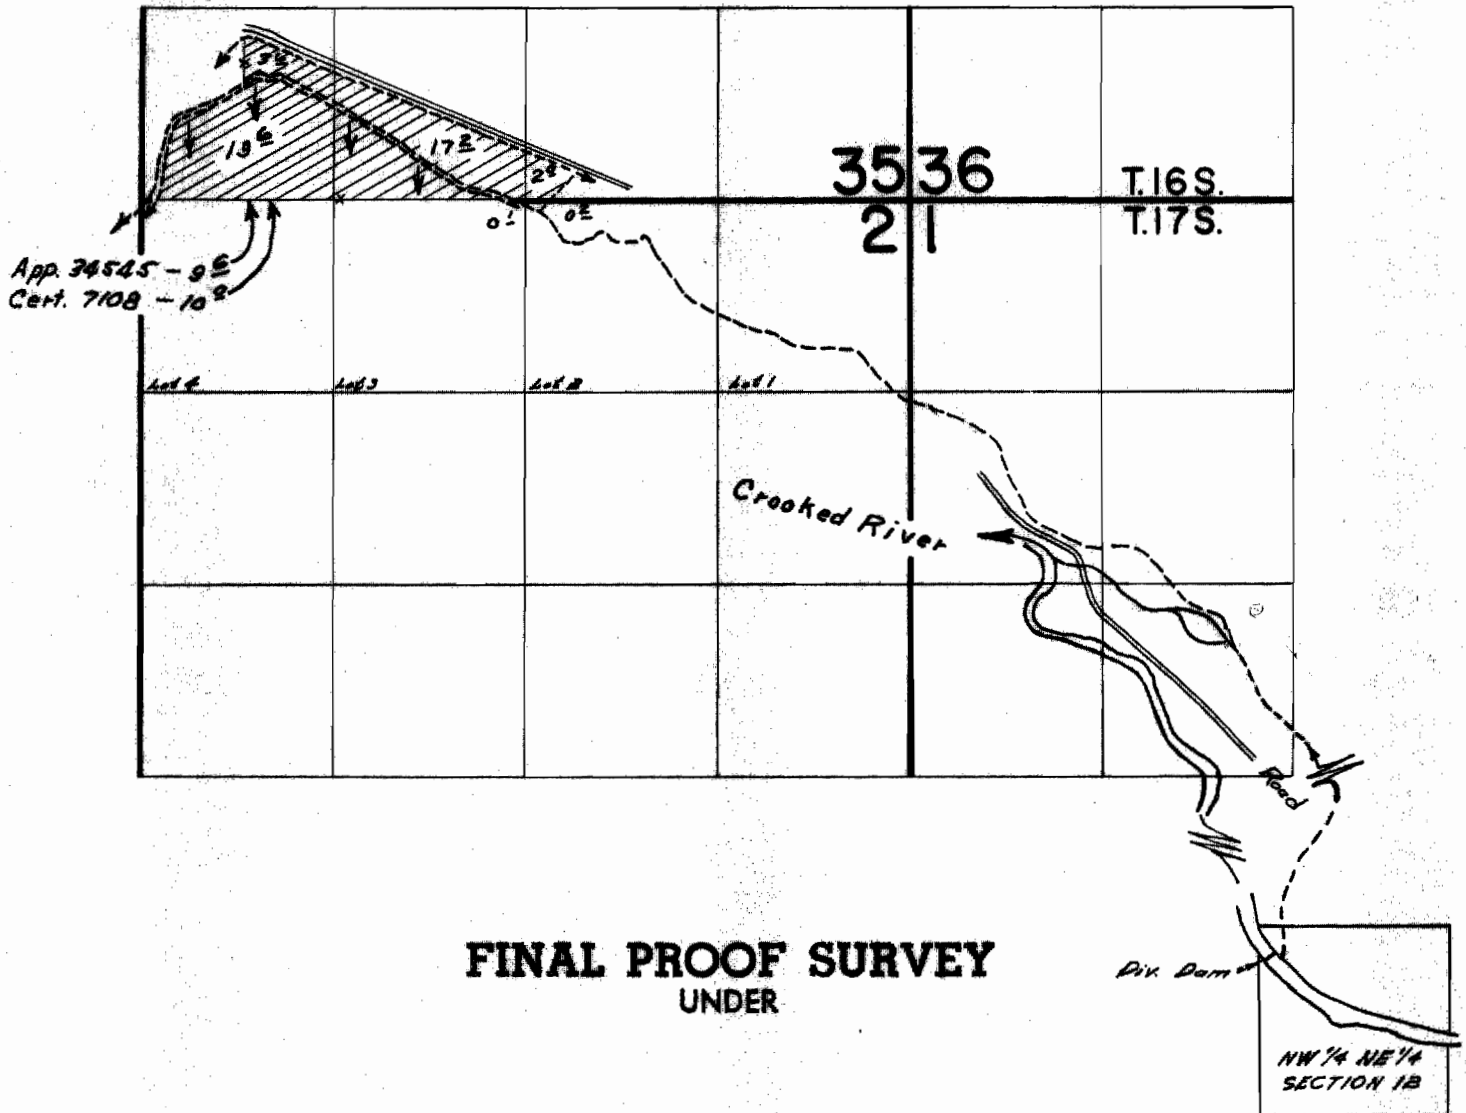

FINAL PROOF SURVEY
UNDER

Application No. 34545... Permit No. 27191...
IN NAME OF

MILLER TWEEDT

June 8 1968 Wm. J. Ruppert
Surveyed Oct. 1, 1964, by R. Jackson