


T.34&35S. R.14W. W.M.

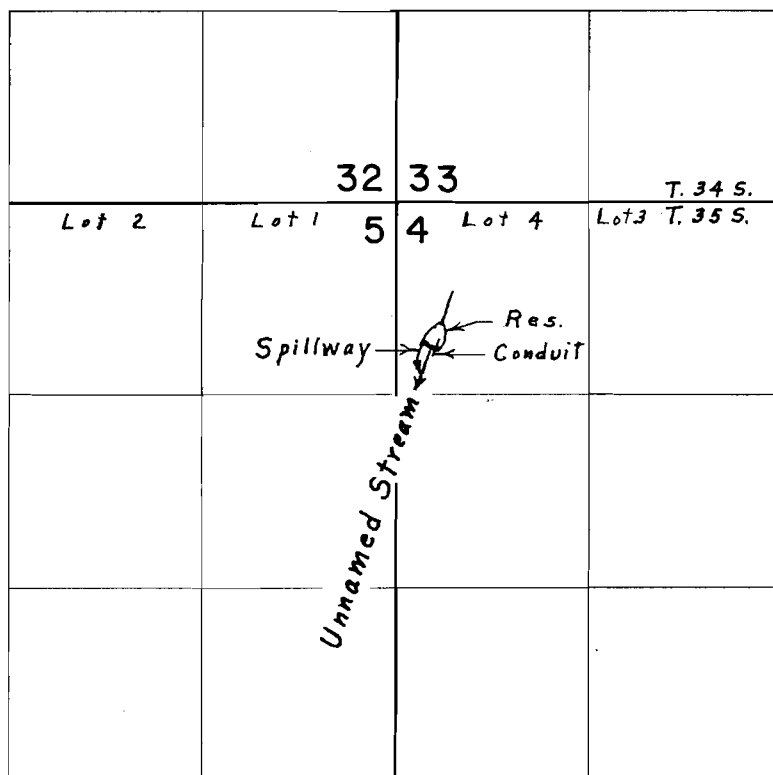

Div. Pt. located 1000' S. & 250' E. from N.W. Cor. Sec. 4

FINAL PROOF SURVEY
UNDER

R-43944 R-4976
Application No. 43844 Permit No. 32422
IN NAME OF

Jake, Lillian, Wayne, & Colleen Krieger

Surveyed Aug. 22, 1974, by L. E. Gould