



T.16S. R.10E. W.M.

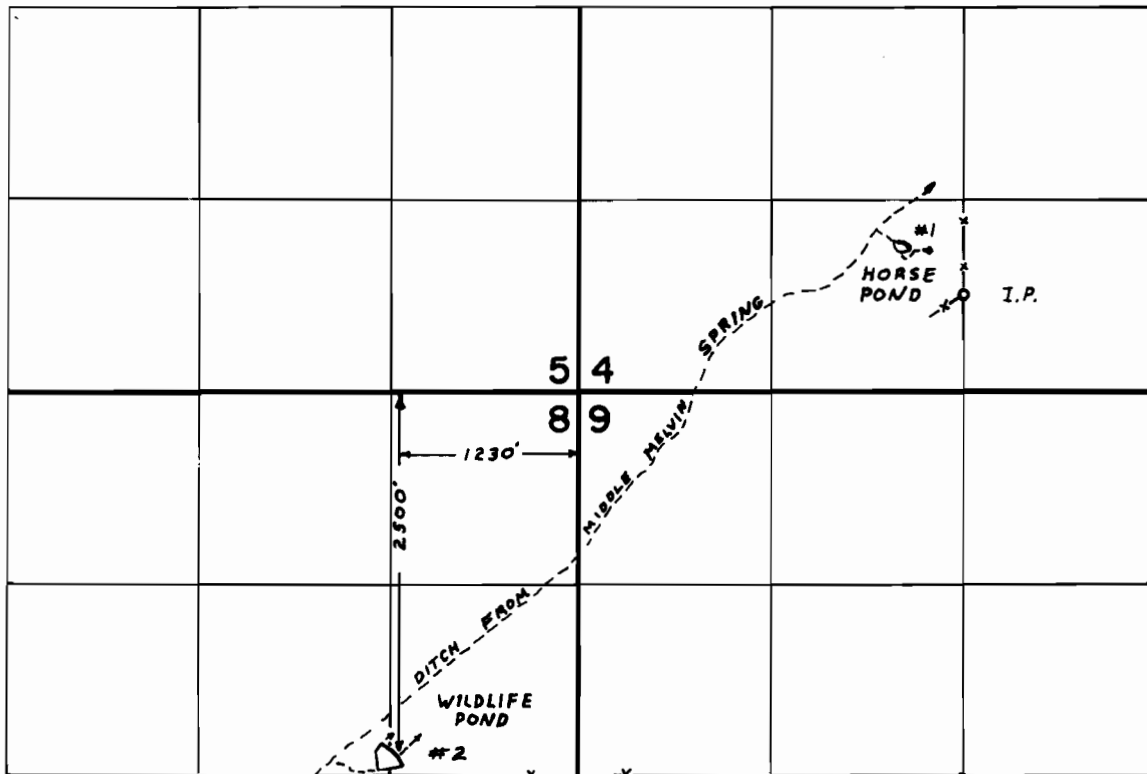

DIV. #1 LOC. 2270' E. & 990 N. FROM S.W. COR. SEC. 4

T.16S. R.9E. W.M.

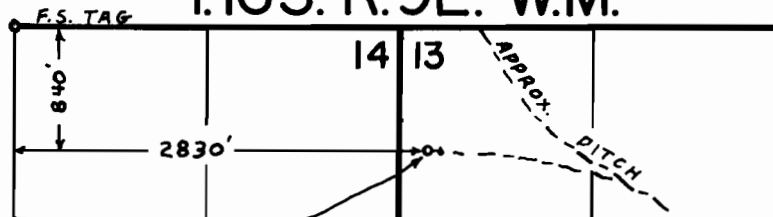

MIDDLE MELVIN SPRING

FINAL PROOF SURVEY
UNDER

R-52425 R-6312
Application No. 52426 Permit No. 39430
IN NAME OF

STEPHEN EBERLY THOMPSON, JR.

Surveyed NOV. 4, 1977, by R.G. MUCKEN