


T. 32S., R. 3 W., W.M.

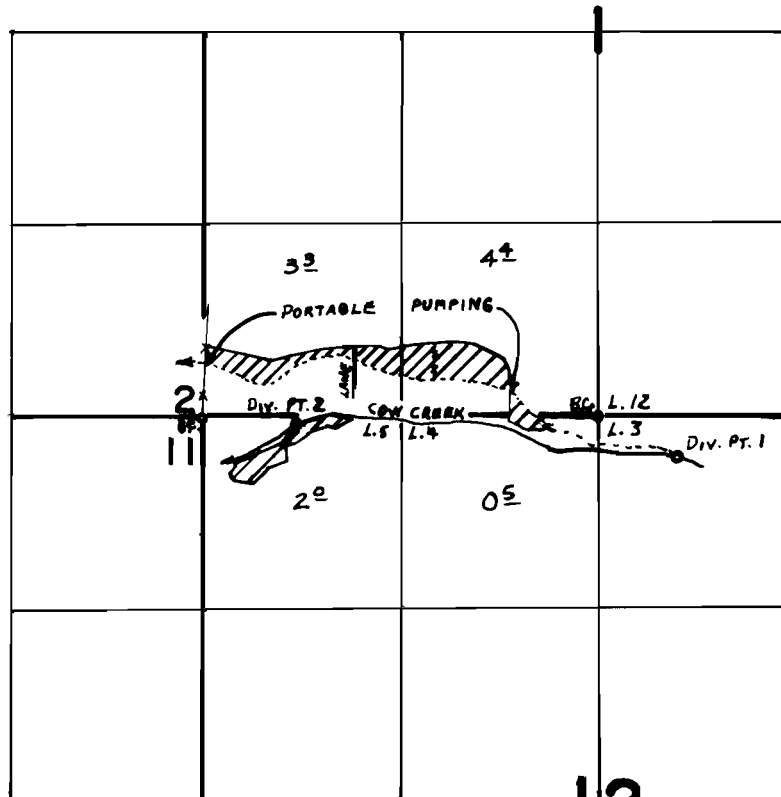

DIV. PT. 1 LOC. 3250' E. & 270' S. FROM NW COR. SEC. 12
DIV. PT. 2 LOC. 680' E. & 50' S. FROM NW COR. SEC. 12

FINAL PROOF SURVEY
UNDER

Application No. 41970. Permit No. 31417....
IN NAME OF

Frank Corder et al

Surveyed MAY 25 1977, by D. NORBY.....