


T.29S., R.5W., W.M.

SECTION 11

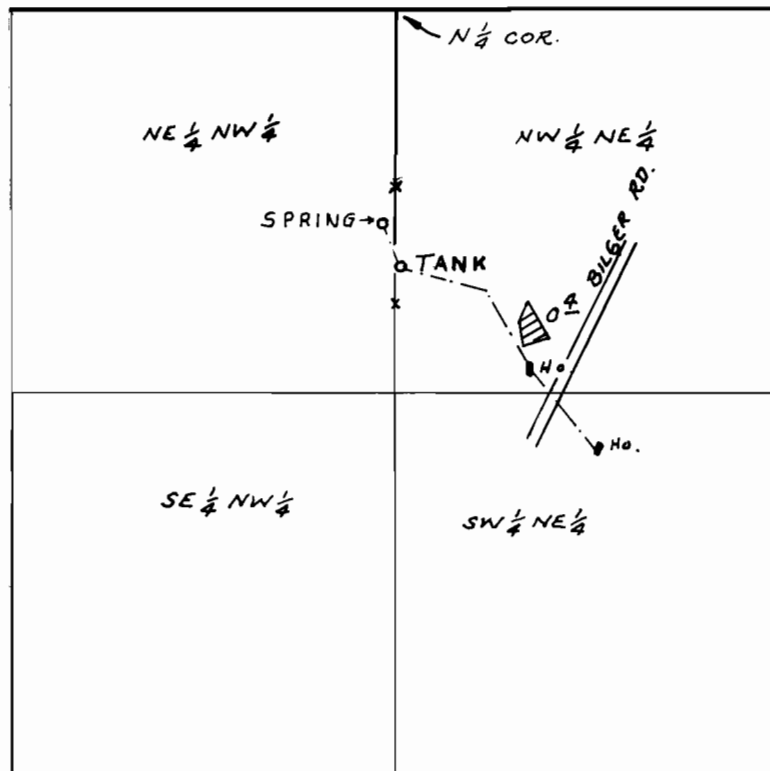

DIV. PT. LOC. 740'S. & 40'W. FROM N. 1/4 COR. SEC. 11

Scale: 1" = 660'

**FINAL PROOF SURVEY**  
UNDER

Application No. 50958.. Permit No. 38467...  
IN NAME OF

**TROY A. & VIOLET M. WALLACE**

Surveyed May 26 1977, by D.M. Norby.....