


T. 29 S., R. 5 W. W.M.

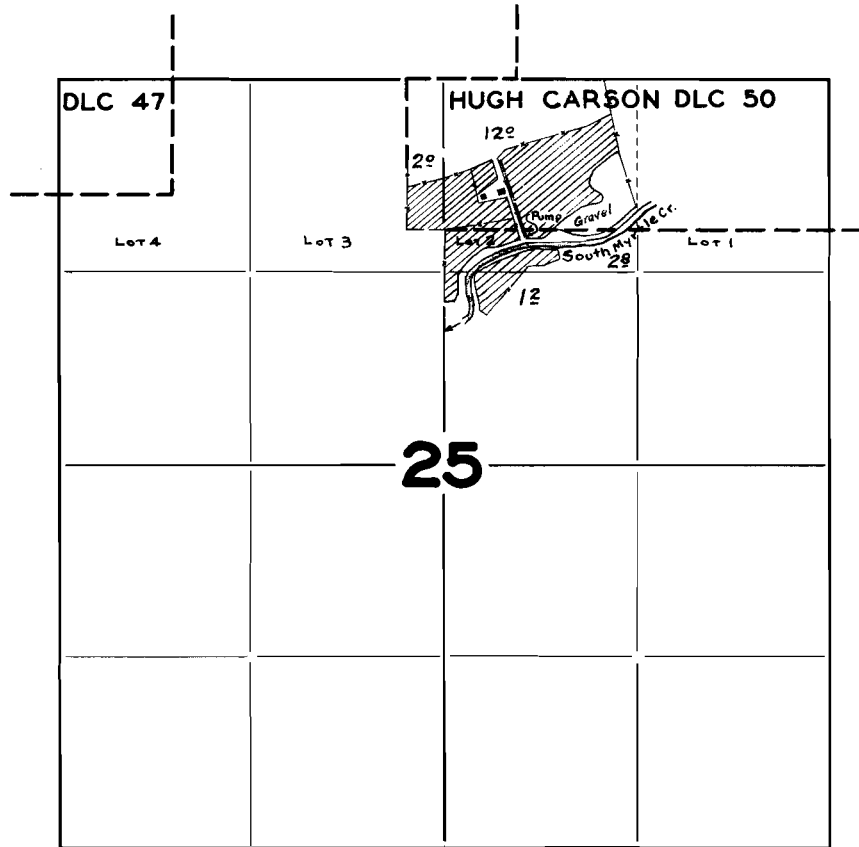

**FINAL PROOF SURVEY
UNDER**

Application No. 19671 Permit No. 15252

IN NAME OF

Howard L. Brownson

Surveyed Sept. 8, 1943, by Geo. D. Adelman