


T.8&9S., R.27E., W.M.

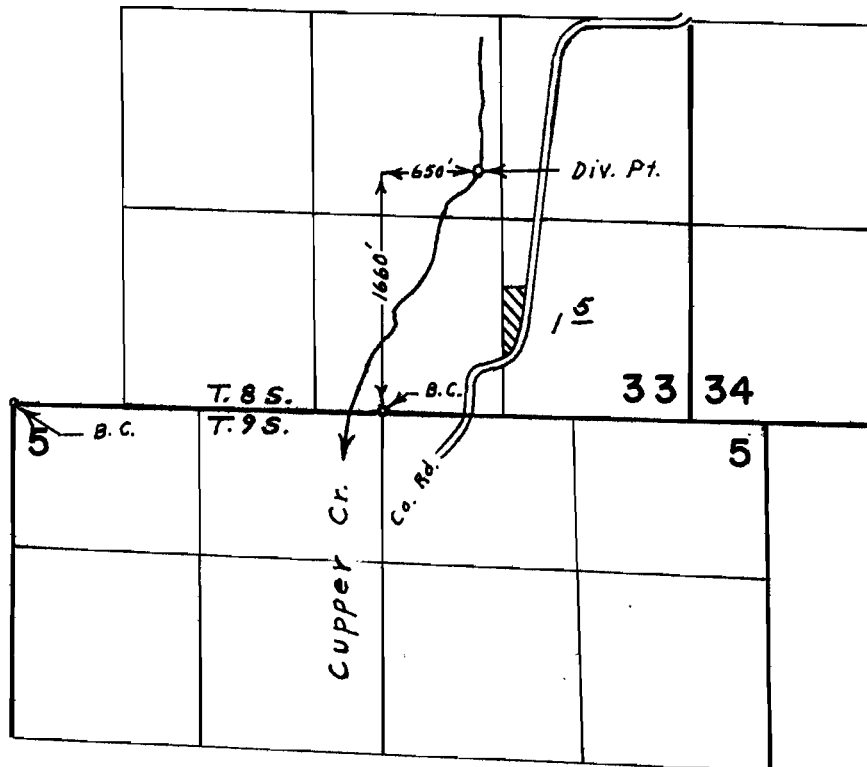

RECEIVED
STATE ENGINEER

SALLY & WILLARD REEVE

Application No. 30048
Permit No. 37570

3FF-45 / 1991-T