


T.10S.R.25 & 26 E.W.M.

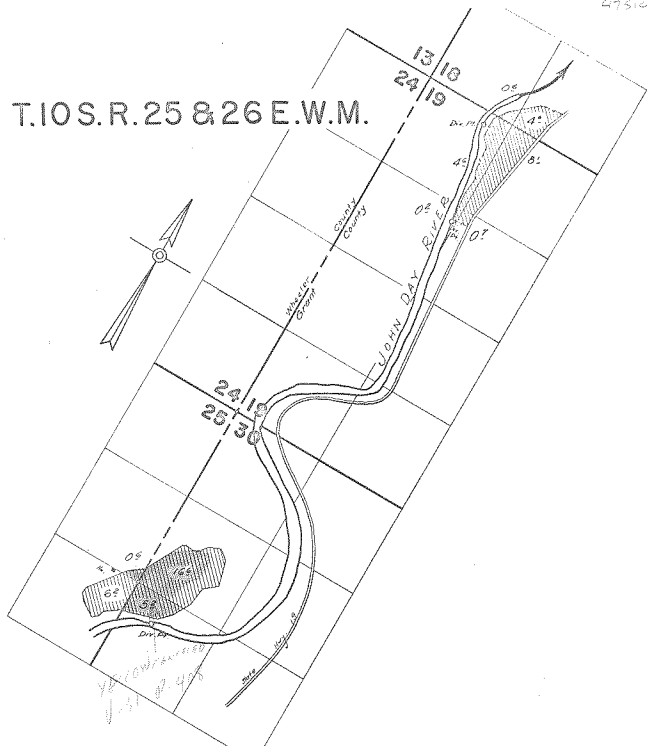

FINAL PROOF SURVEY
UNDER

Application No. 29076... Permit No. 25276...
IN NAME OF

EDWARD R. & DORIS C. CHILCOTT

Surveyed August 25 1901... by *R. Jackson*