


T.13S. R.29 E. 30E. WM.

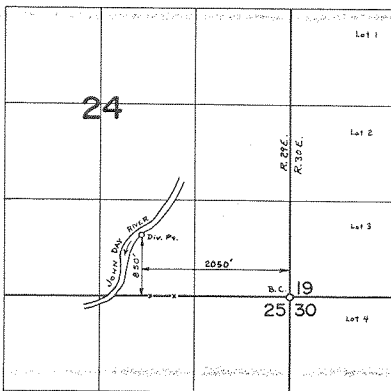

**FINAL PROOF SURVEY**  
UNDER

Transfer No. M-149  
IN NAME OF

JOHN & JOHN A. MASSON

Surveyed SEPT. 19, 1977., by S. BROWN