


T. 36 S., R. 4 W., W. M.

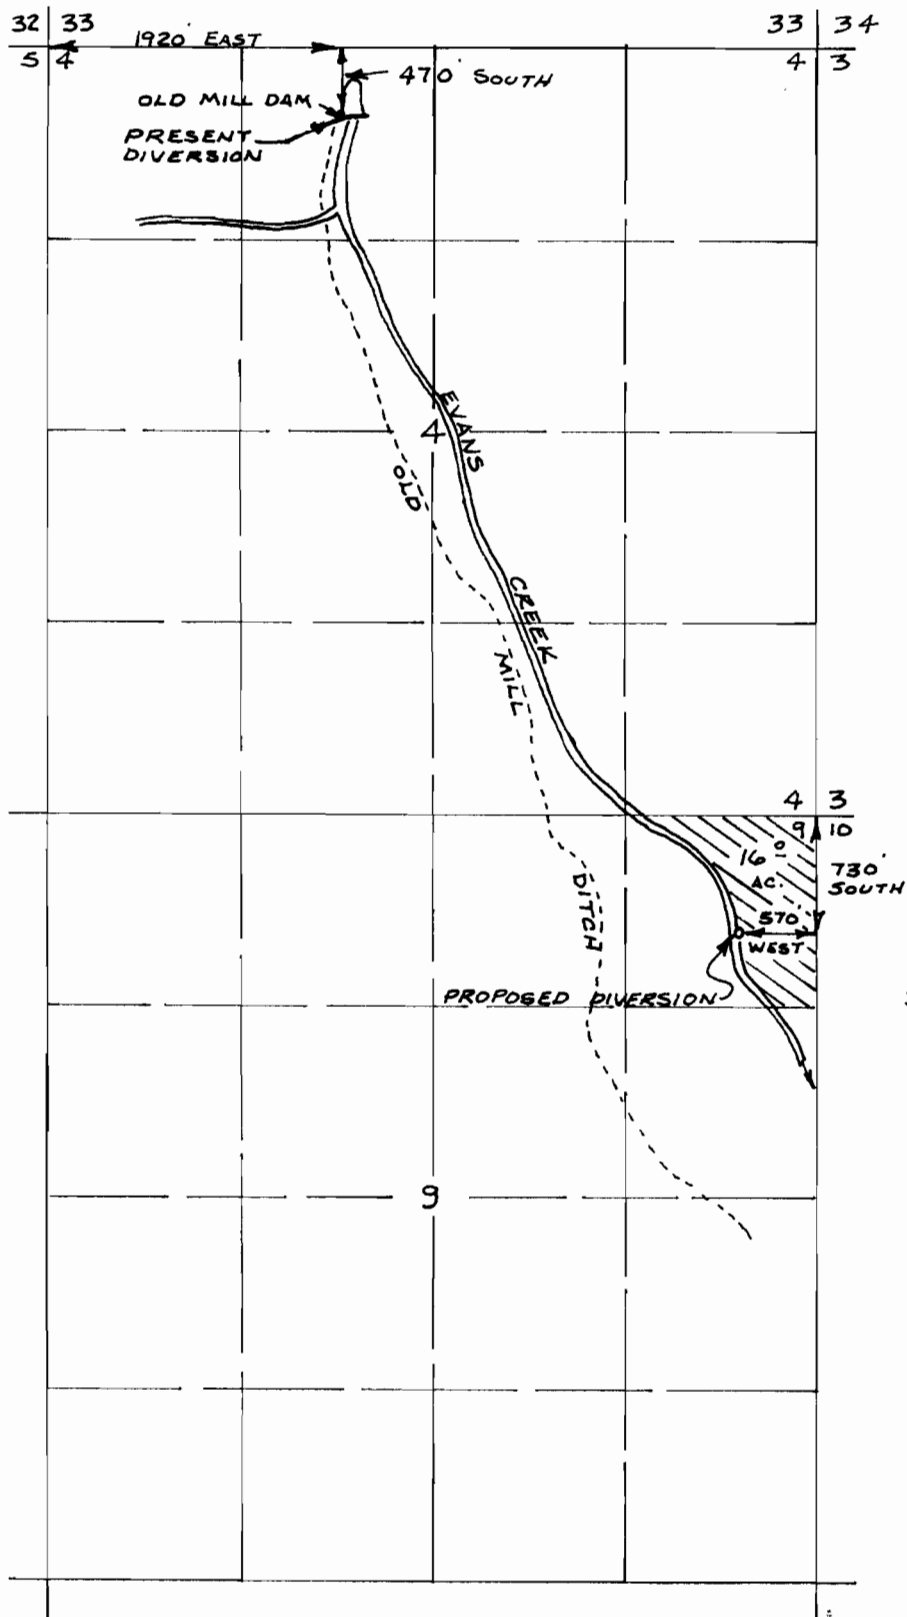

MAP TO ACCOMPANY APPLICATION OF ARTHUR W. PATTERSON
FOR A CHANGE IN POINT OF DIVERSION.

JULY 2, 1963

F. L. S.