


T. 36S., R. 1W., W.M.

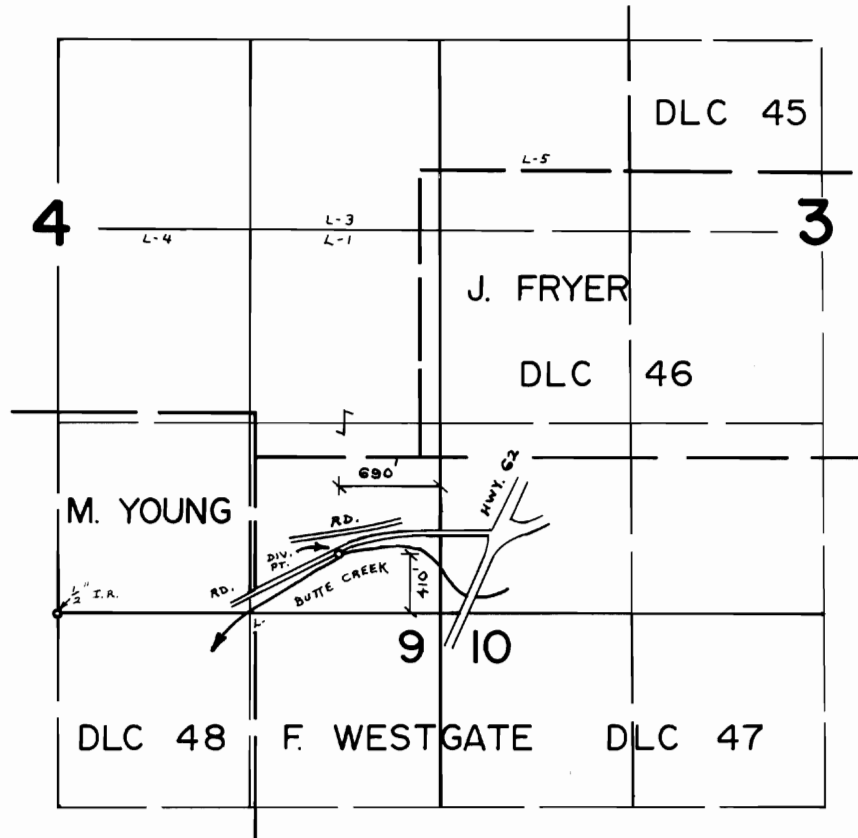

FINAL PROOF SURVEY
UNDER

Application No. TR-3861 Permit No.
IN NAME OF

VIRGINIA LEMON

Surveyed AUG. 22 1978, by B. SUND