


# T. 15S., R. 4W., W.M.

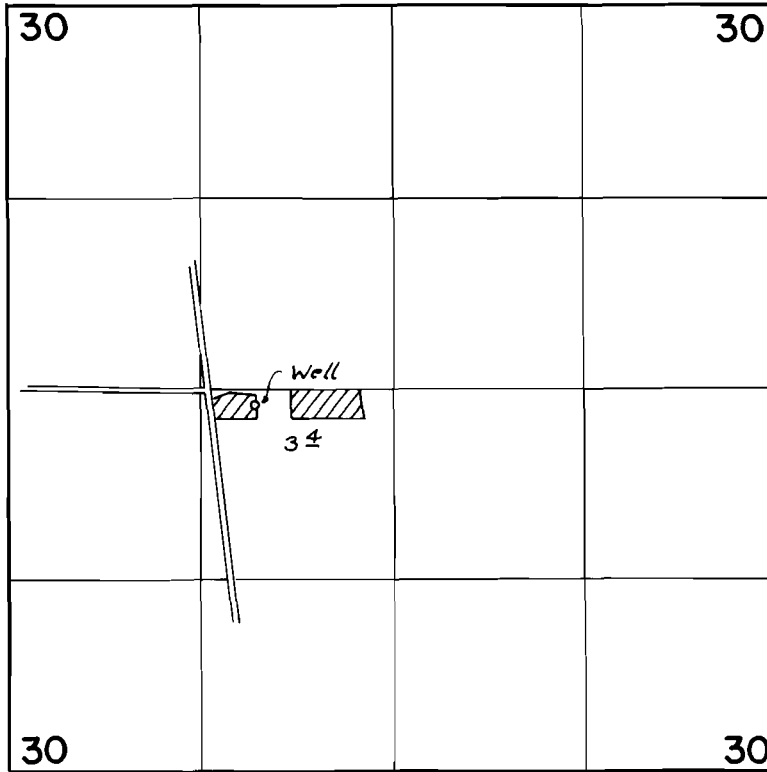

Well Loc: 2540' N. & 3580' W. from S.E. Cor.  
Sec. 30

## FINAL PROOF SURVEY UNDER

Application No. G-5654 Permit No. G-5483  
IN NAME OF

Clarry Ottosen

Surveyed May 14, 1976 by D.M. Norby